


T. 8 S. R. 3 W., W.M.


SEC. 25

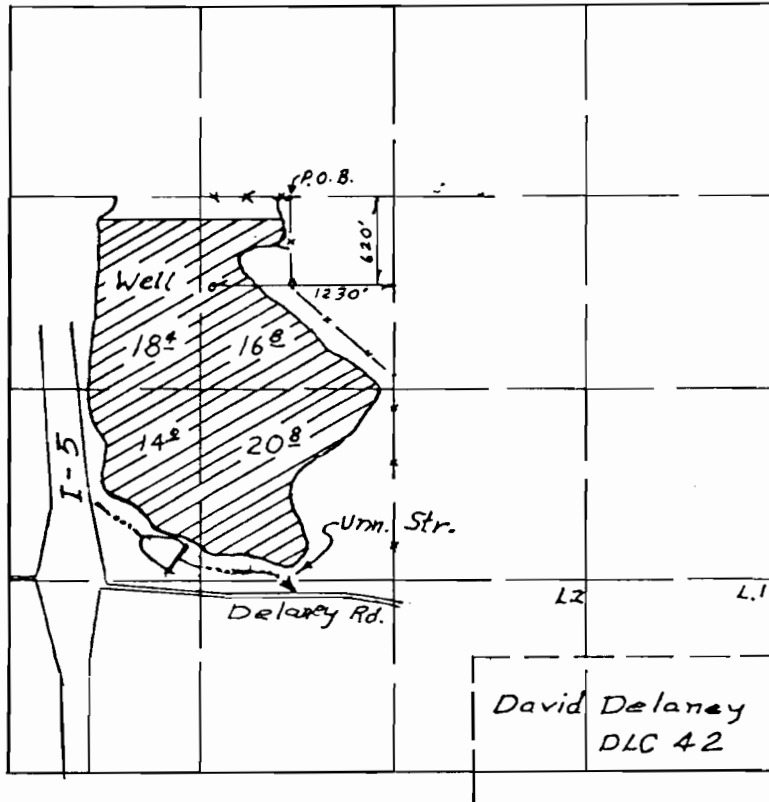

FINAL PROOF SURVEY MAP
FOR

JOHN D. MILLER

APPL. NO. G-12479 PER. NO. G-11363

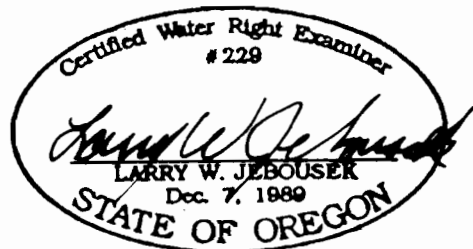

THIS MAP WAS PREPARED FOR THE PURPOSE OF IDENTIFYING THE LOCATION OF A WATER RIGHT ONLY AND IS NOT INTENDED TO PROVIDE LEGAL DIMENSIONS OR LOCATION OF PROPERTY OWNERSHIP LINES.