

RECEIVED


T. 9 S., R. 45 E., W.M.

JUN 3 0 1997

WATER RESOURCES DEPT
SALEM, OREGON



SCALE 1" = 1320'

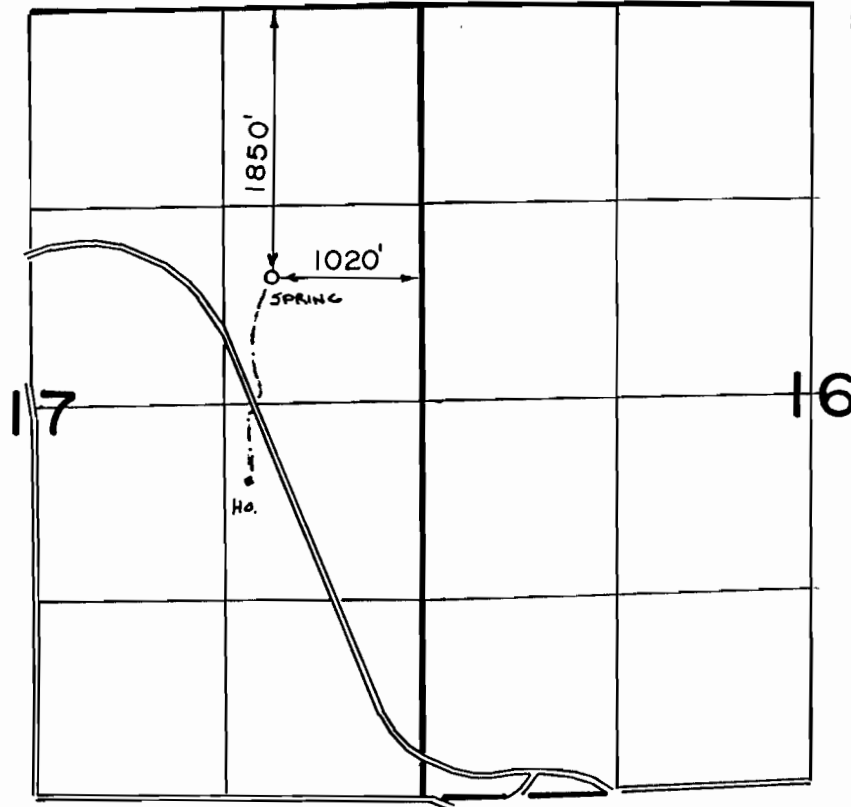

FINAL PROOF SURVEY

UNDER

APPL. 72639

PER. 52420

IN NAME OF

GEORGE V. & BONNADINE M. NICOLESCU

SURVEYED SEPT. 9, 1996

The purpose of this map is for identifying the location of the water right and is not intended to provide legal dimensions of property ownership lines.

