


G. 9232
T 8283
T 8017
53150
76269
T 8283

T. 26S., R. 16E., W.M.

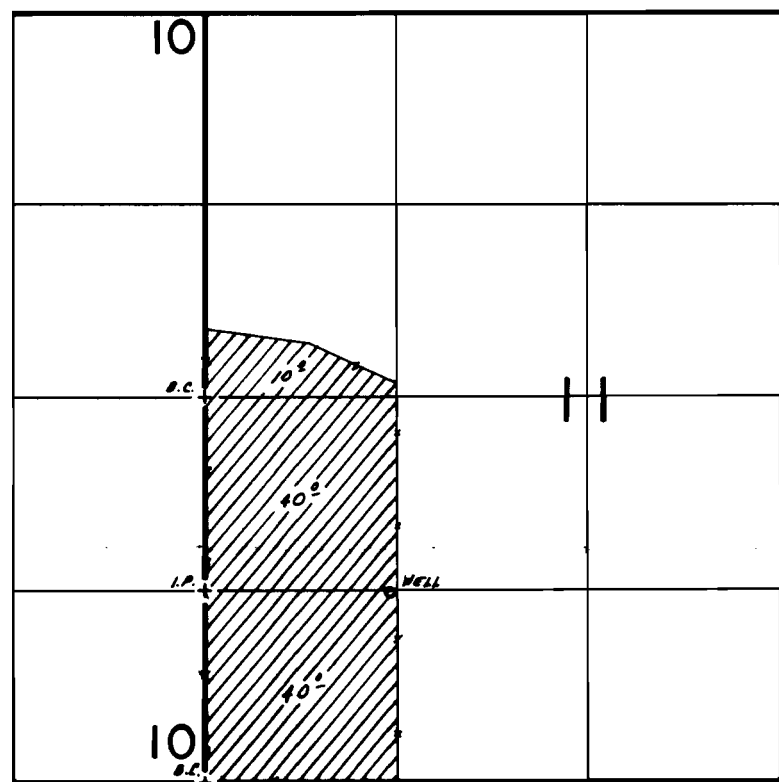

WELL LOC: 1300' N. & 1290' E. FROM SW COR. SEC. 11

Scale: 1"=1320'

FINAL PROOF SURVEY
UNDER

Application No. G-10155.. Permit No. G-9232.....
IN NAME OF

.....LAWRENCE W. HICKS (MAUNEY).....

Surveyed OCT. 31... 1984, by B.W. BISHOP.....