


G 6064
T8216
48732
76271
T8216

T.27S.R.17E.W.M.

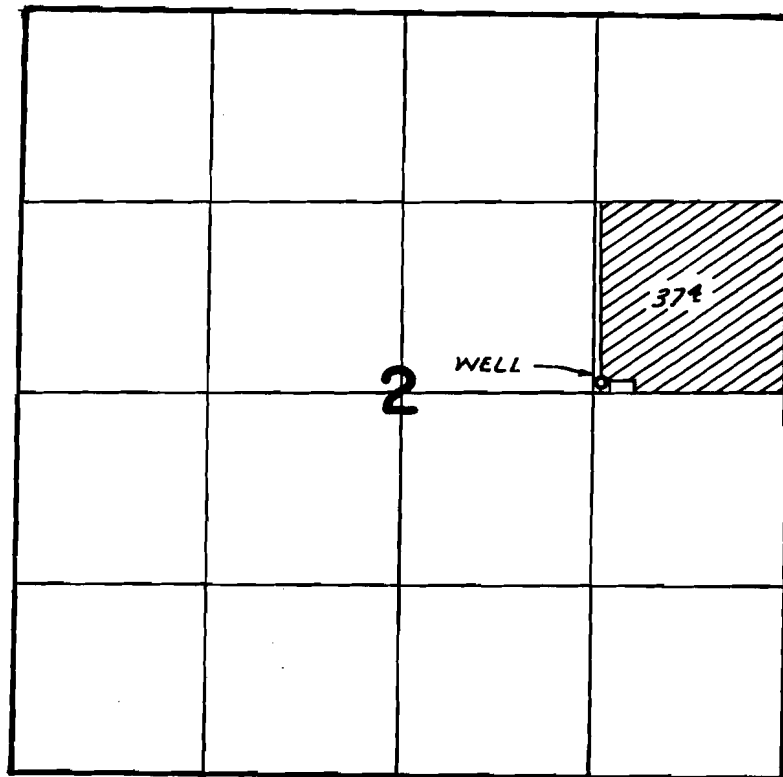

WELL LOC: 70' N. & 1260' W. FROM E. & COR. SEC. 2

FINAL PROOF SURVEY
UNDER

Application No. G-6469 Permit No. G-6064
IN NAME OF

HENRY JENSEN

Surveyed AUG. 29, 1978, by S. P. APPLGATE

CHZ-2KK-213 RGTm