


UNITED STATES  
DEPARTMENT OF THE INTERIOR  
BUREAU OF LAND MANAGEMENT

SECTION 25  
SW 1/4 NE 1/4


TOWNSHIP 38S., RANGE 6W., W. M.

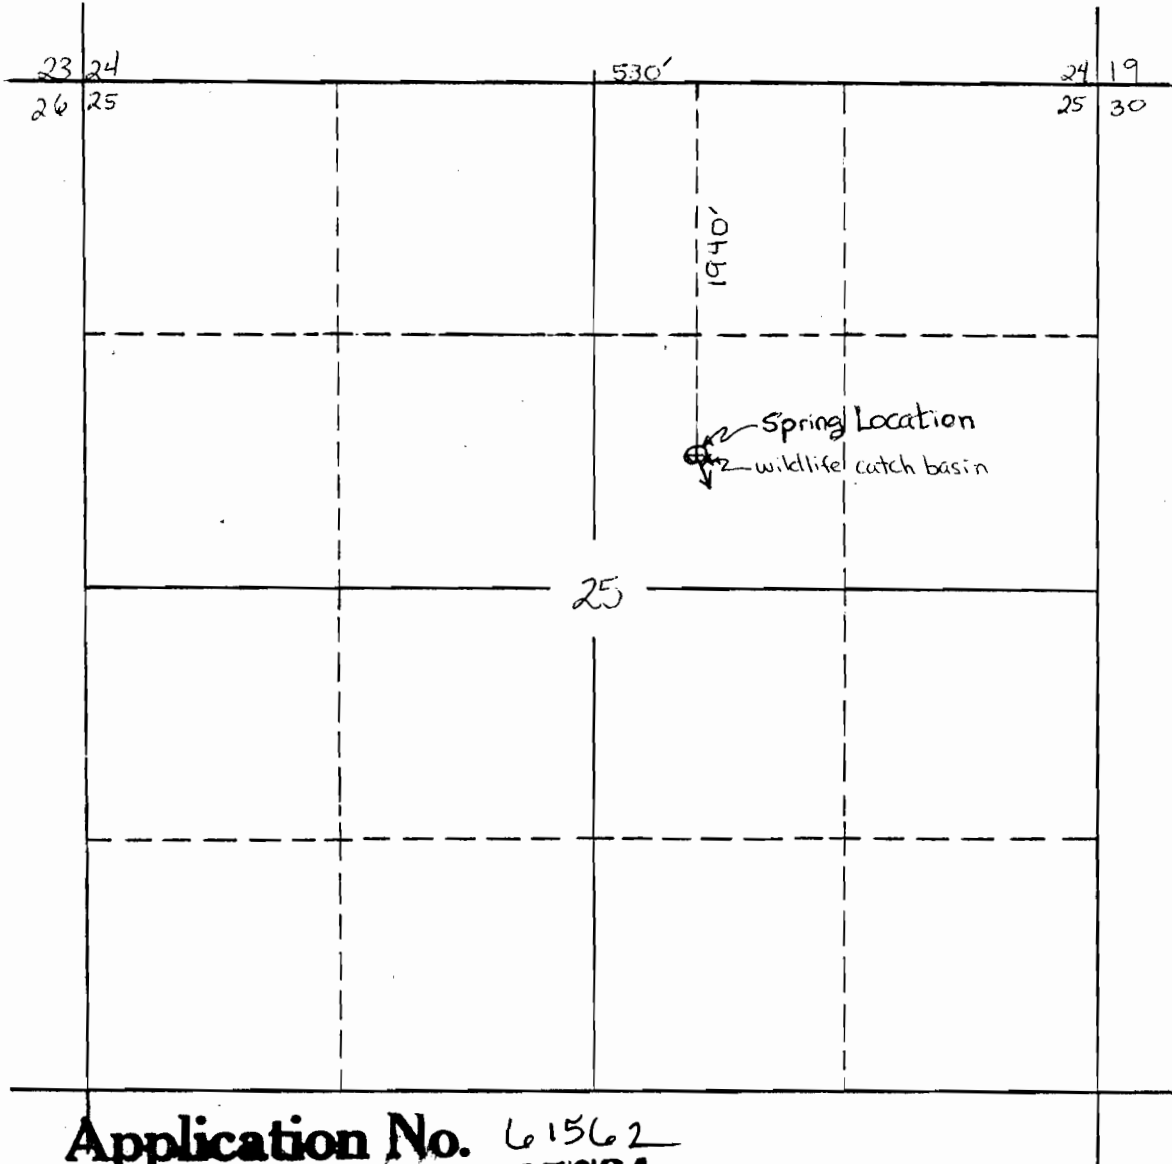

Application No. 61562  
Permit No. 45764  
SCALE: 1" = 1000'

**RECEIVED**  
APR 21 1981  
WATER RESOURCES DEPT  
SALEM, OREGON