

Application No. 7-149
Permit No. 71013

Application No. 7-149
Permit No. G10511

CERTIFICATE NO.

RECEIVED

JUL 3 1985


WATER RESOURCES DEPT.
SALEM, OREGON

BM 436

RECEIVED

DEC 27 1994

WATER RESOURCES DEPT.
SALEM, OREGON

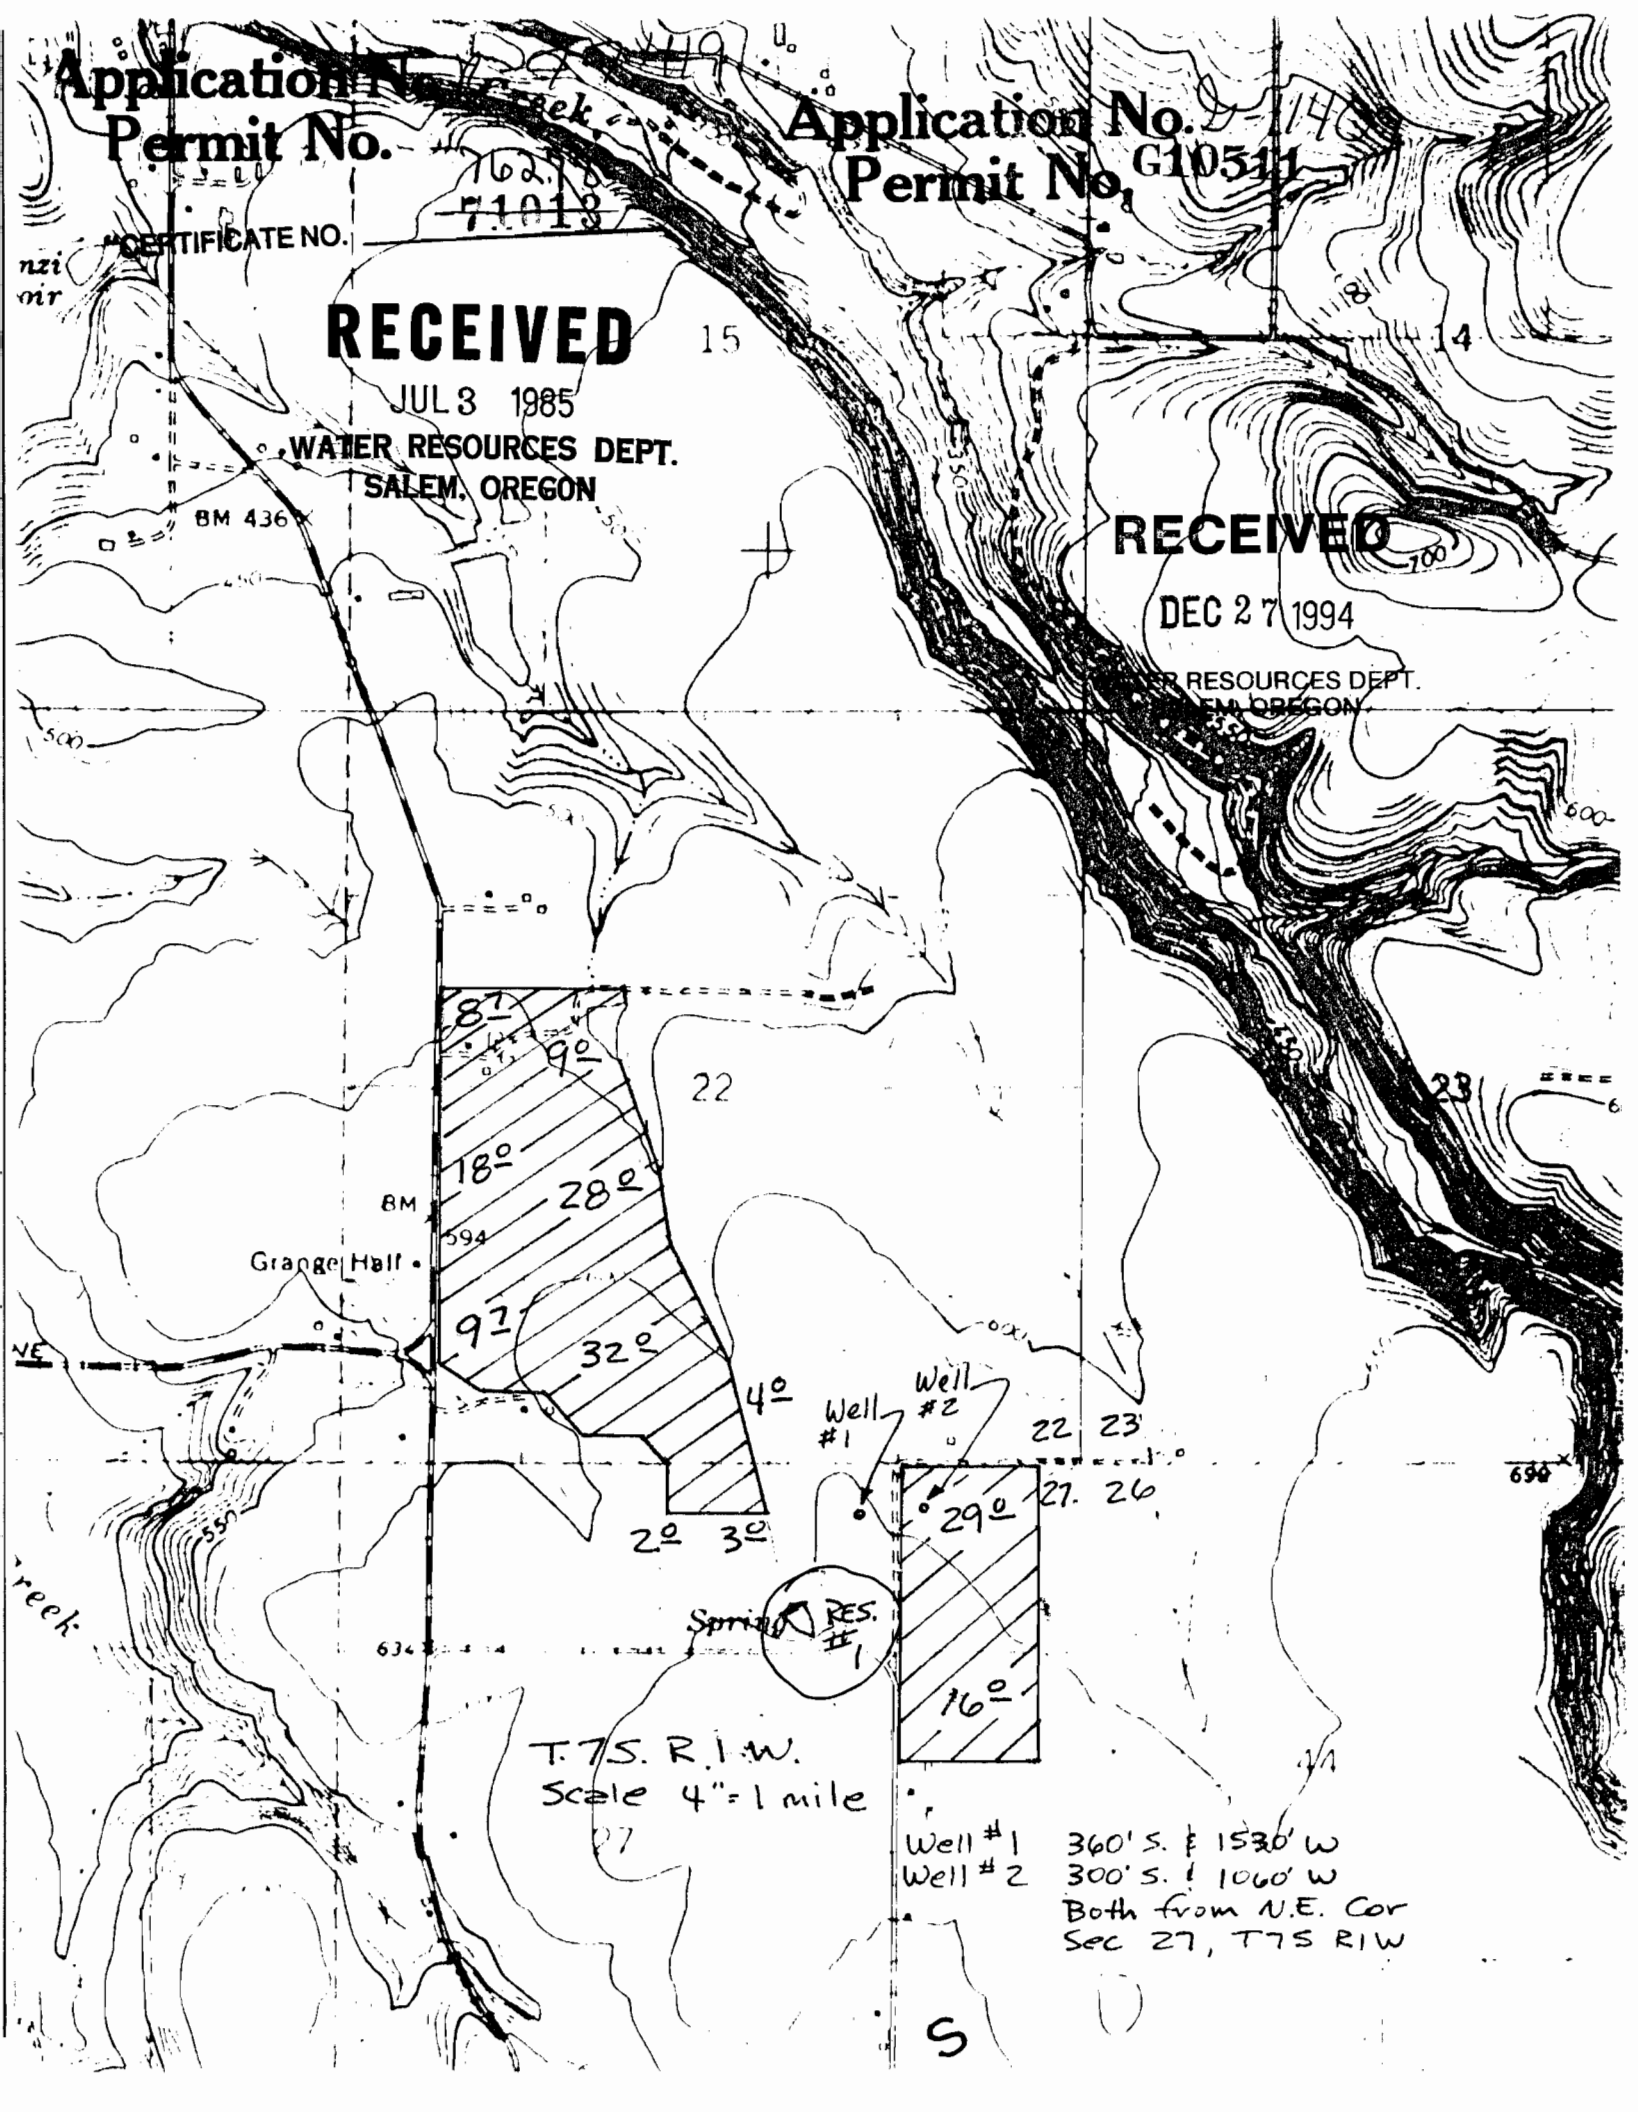

Grange Hall

Well #1

Well #2

Spring RES. #1

T. 7S. R. 1W.
Scale 4" = 1 mile

Well #1
Well #2

360' S. & 1530' W
300' S. & 1060' W
Both from N.E. Cor
Sec 27, T7S R1W