


T.29S. R.5W. W.M.

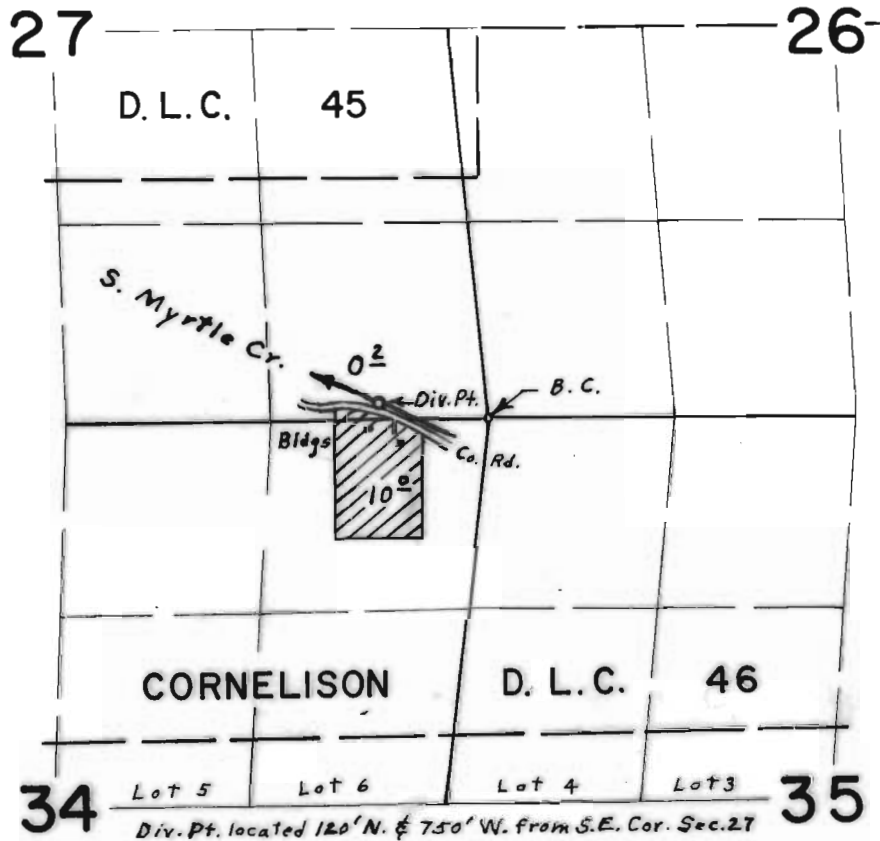

FINAL PROOF SURVEY
UNDER

Application No. 50997. Permit No. 38492.
IN NAME OF

W. ROLLAND EMMERSON

Surveyed May 24, 1976, by L. E. Gould