


T.29S. R.5W. W.M.

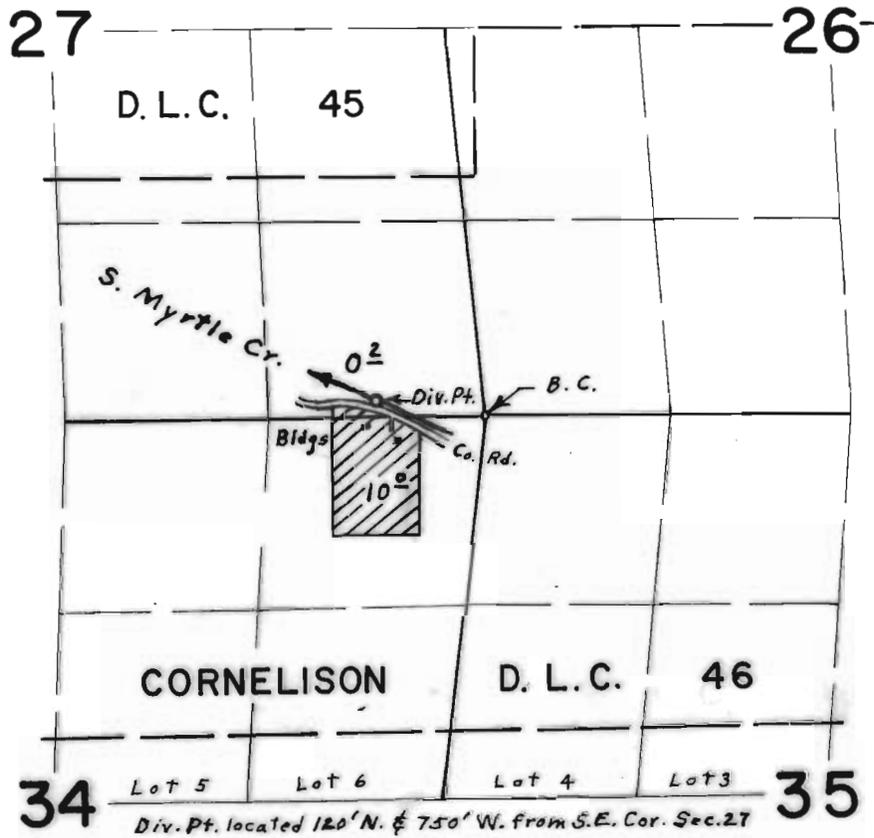


FINAL PROOF SURVEY
UNDER

Application No. 50997. Permit No. 38492.
IN NAME OF

W. ROLLAND EMMERSON

Surveyed May 24, 1976, by L. E. Gould

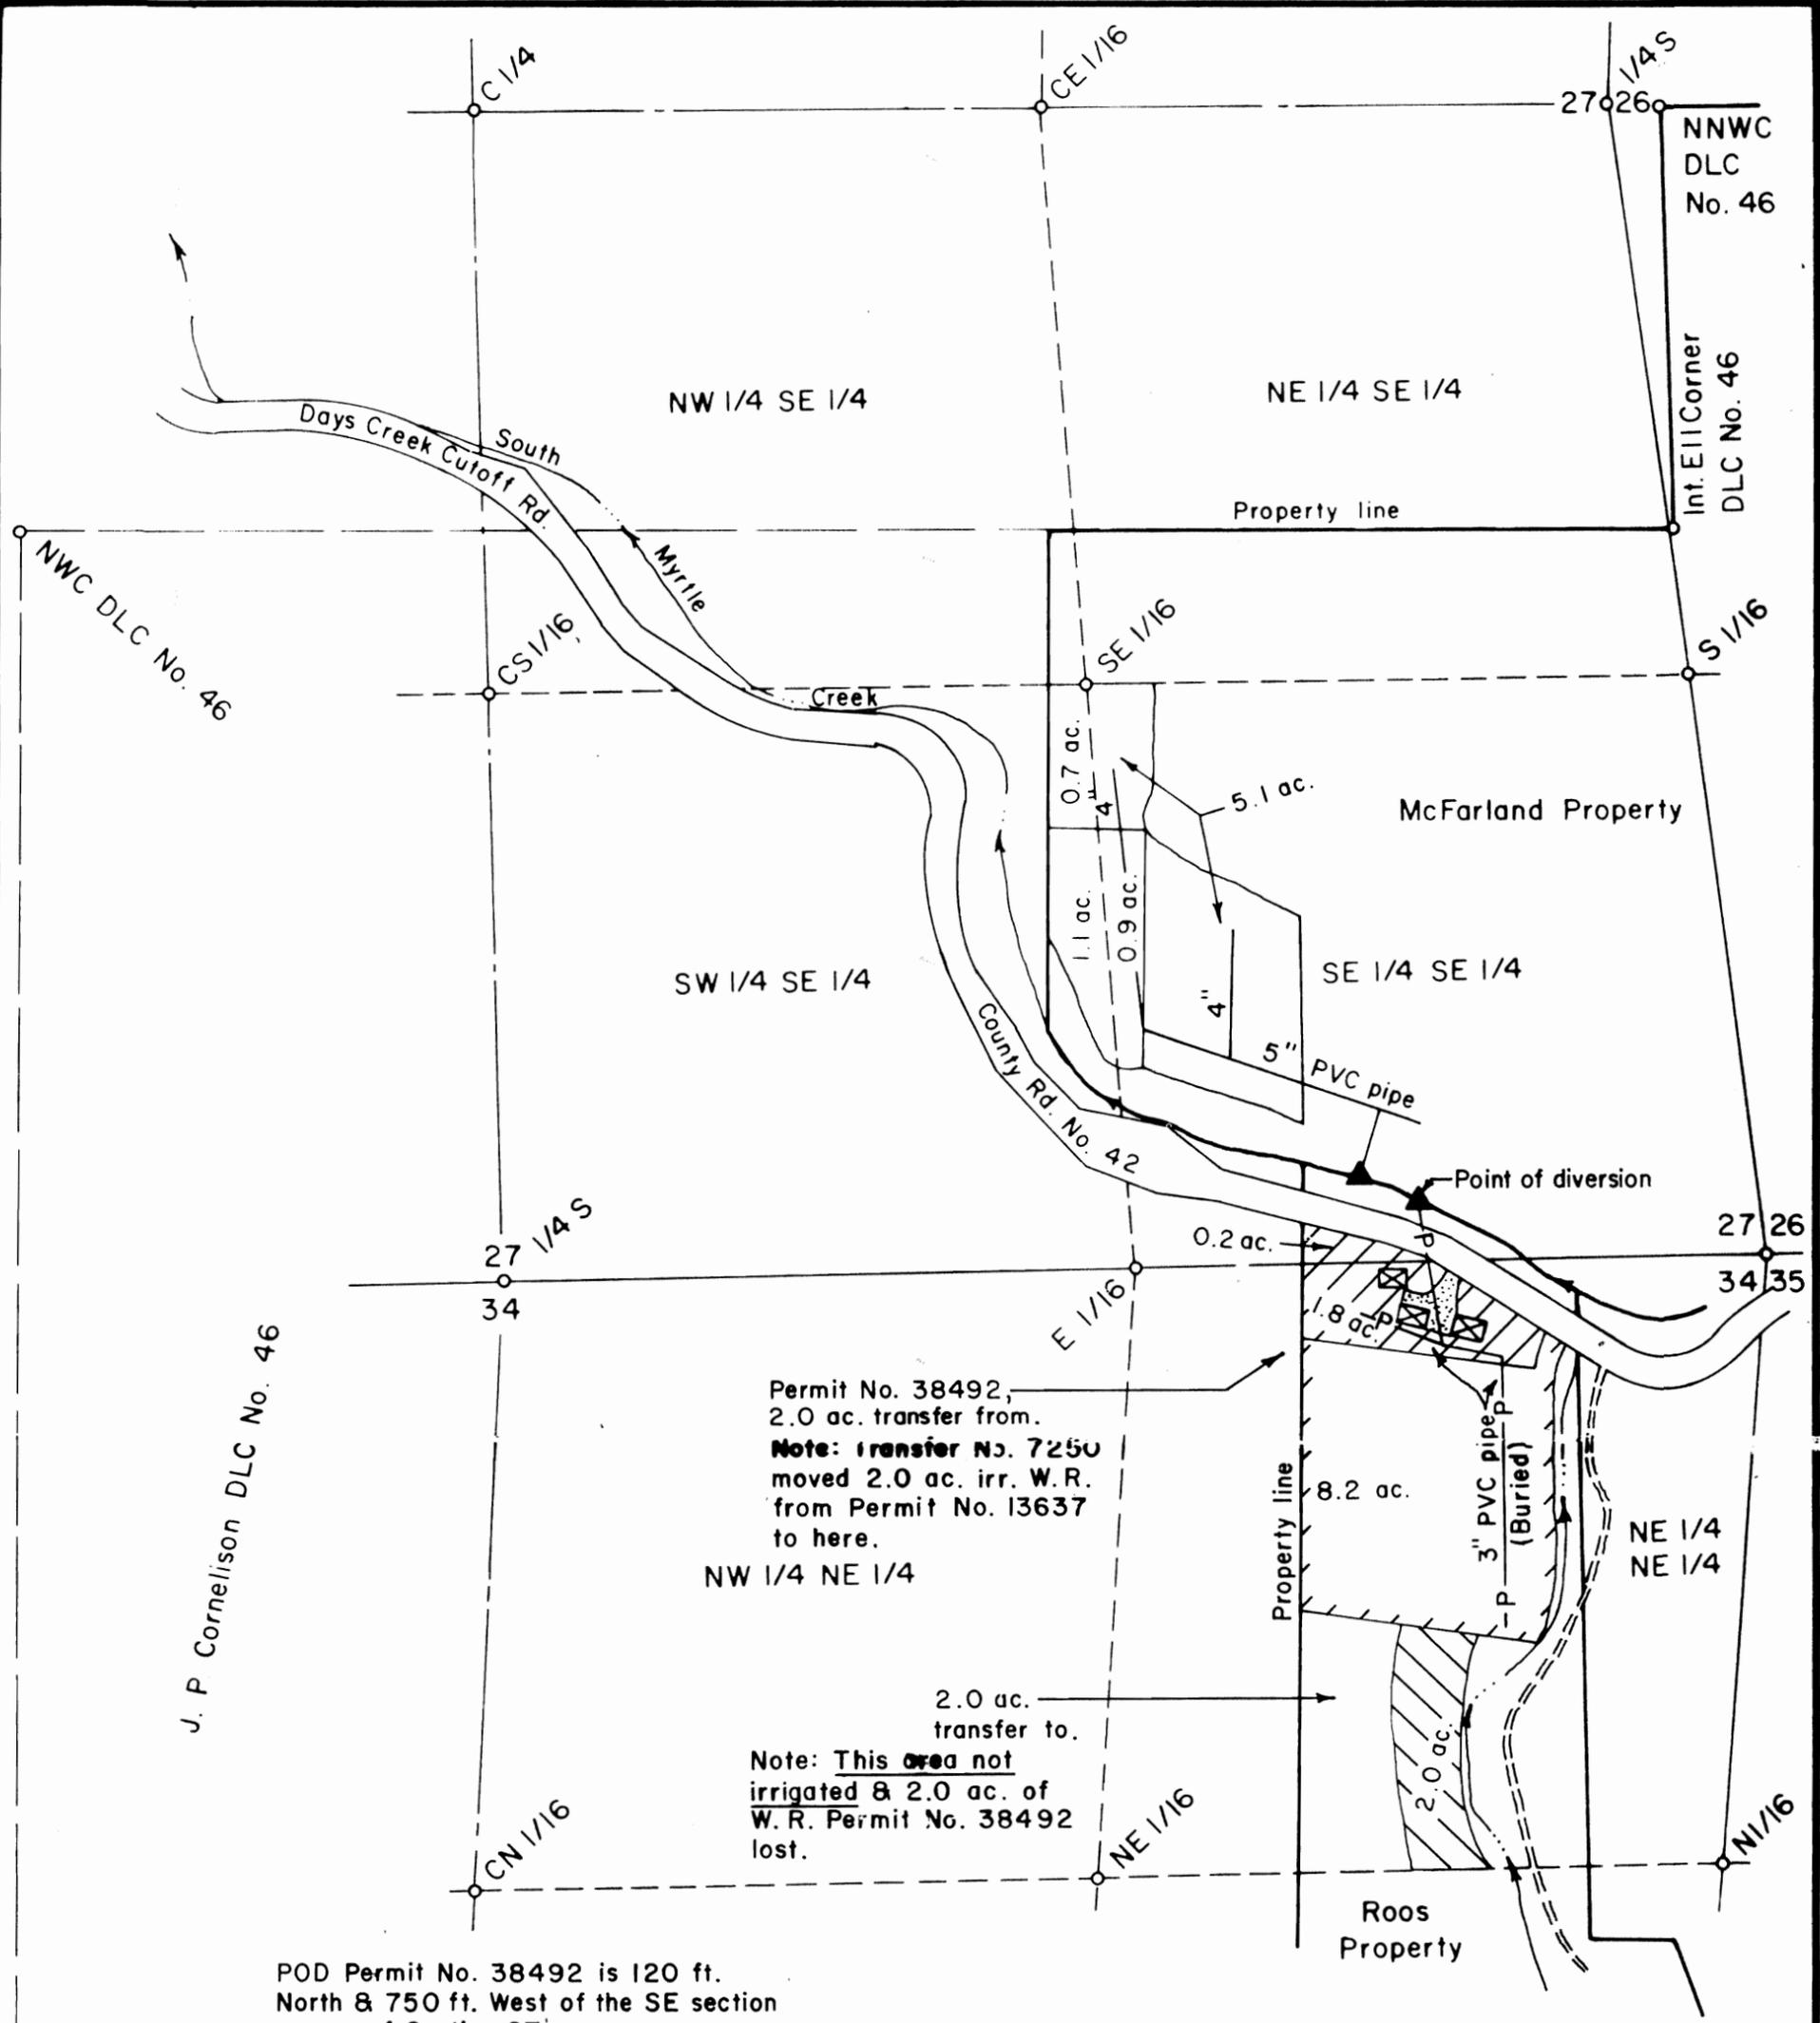

J. P. Cornelison DLC No. 46

Permit No. 38492,
2.0 ac. transfer from.
Note: transfer No. 7250
moved 2.0 ac. irr. W.R.
from Permit No. 13637
to here.
NW 1/4 NE 1/4

2.0 ac.
transfer to.
Note: This area not
irrigated & 2.0 ac. of
W. R. Permit No. 38492
lost.

POD Permit No. 38492 is 120 ft.
North & 750 ft. West of the SE section
corner of Section 27.


**CLAIM OF BENEFICIAL USE OF
WATER RIGHT TRANSFER**

**in the J. P. Cornelison DLC No. 46 and in the
SE 1/4 SE 1/4 of Section 27 & in the NE 1/4
NE 1/4 of Section 34, T29S, R5W, W.M.,
Douglas County, Oregon**

**Transfer No. 7251
Permit No. 38492**

For: Stephen A. & Melinda D. Roos
P.O. Box 1067
Myrtle Creek, Oregon 97457

By: Shaner Engineering, Inc.
P.O. Box 1430
Roseburg, Oregon 97470

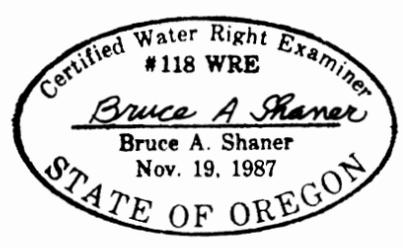

Scale: 1" = 400 ft.

September 17, 2001