



T.33S., R.2E., W. M.

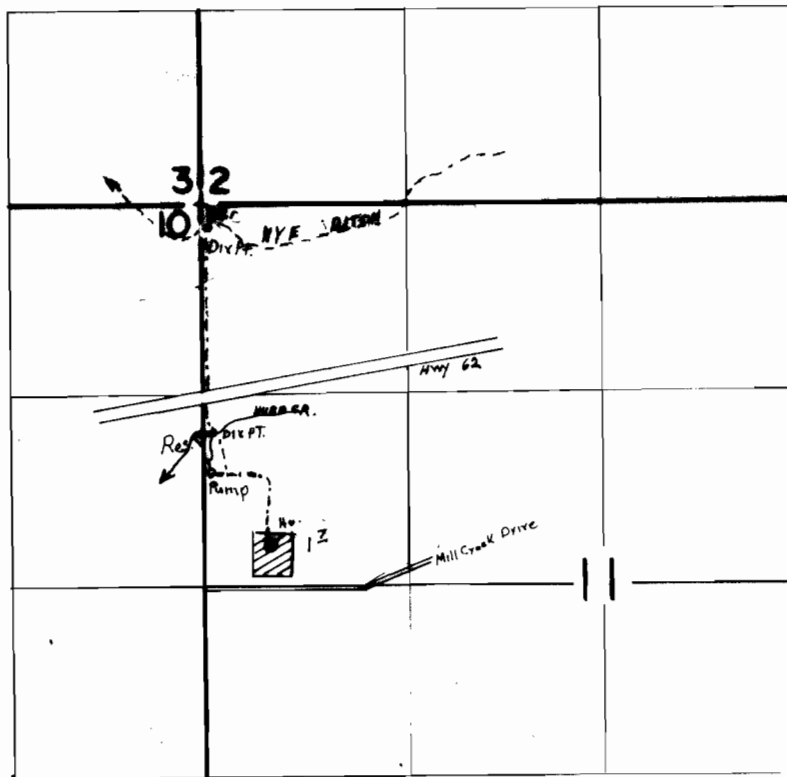

Hurd Creek Div Pt Loc. 1050' N & 90' E From The W1/4 Corner Of Section 11

T. 32S., R. 3E., W. M.

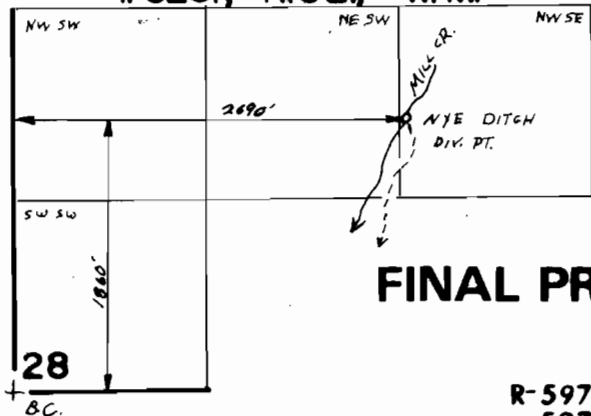

SCALE: 1"=1320'

FINAL PROOF SURVEY
UNDER

R- 59776
59775

R- 8201
45304

Application No. 6374.1.... Permit No. 47213.....

IN NAME OF

...KEITH B. & CINDY L. DAWSON...

Surveyed NOV. 28, 1989., by B.S. JAMES.....