


T.6S.R.1E&W.W.M.

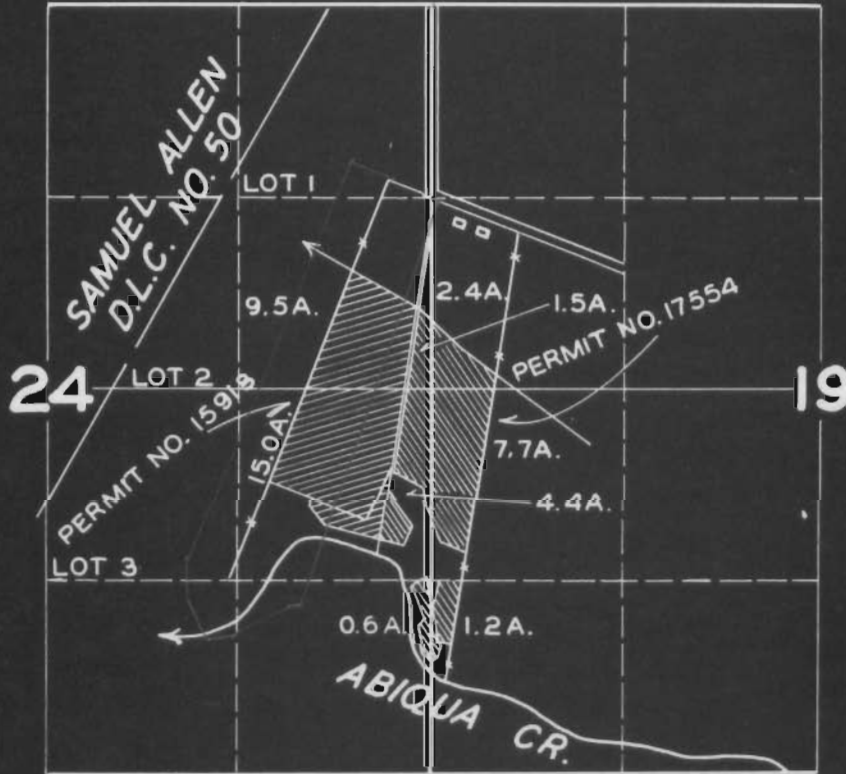

FINAL PROOF SURVEY

UNDER

20376

15913

Application No. 22256 Permit No. 17554

IN NAME OF

CLARENCE MOSER

Surveyed **JULY 23 1948**, by **JAS. E. BUNNELL**