


T.6S.R.1E.W.M.

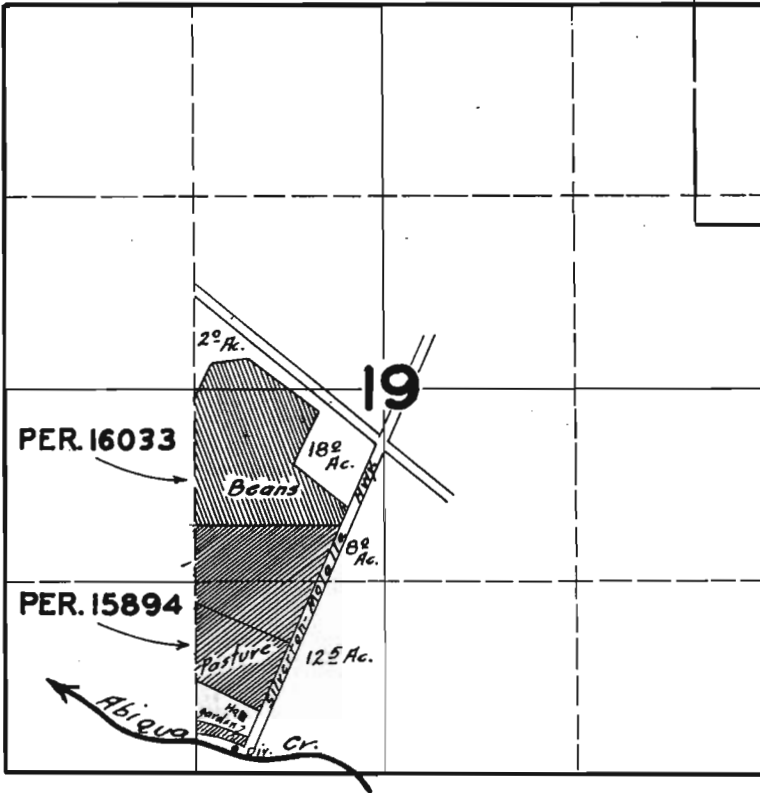

FINAL PROOF SURVEY

UNDER

Application No. 20381 Permit No. 15894
20533 16033

IN NAME OF

HARRY F. BRITTAN

Surveyed JULY 22 1946, by [Signature]