


T.6S. R.1E. W.M.

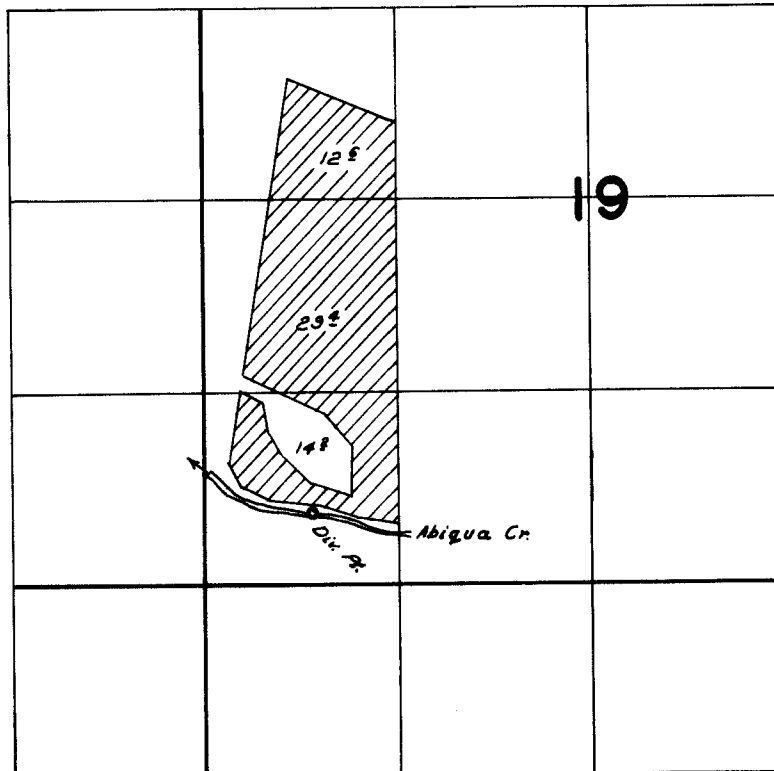

FINAL PROOF SURVEY
UNDER

Application No. *31446* Permit No. *24772*
IN NAME OF

Mr. J. W. Moore

Surveyed *May 28 1959*, by *C. O. Bartels*