


T.34S.,R.1W.,W.M.

RECEIVED

OCT 26 1998

WATER RESOURCES DEPT.
SALEM, OREGON

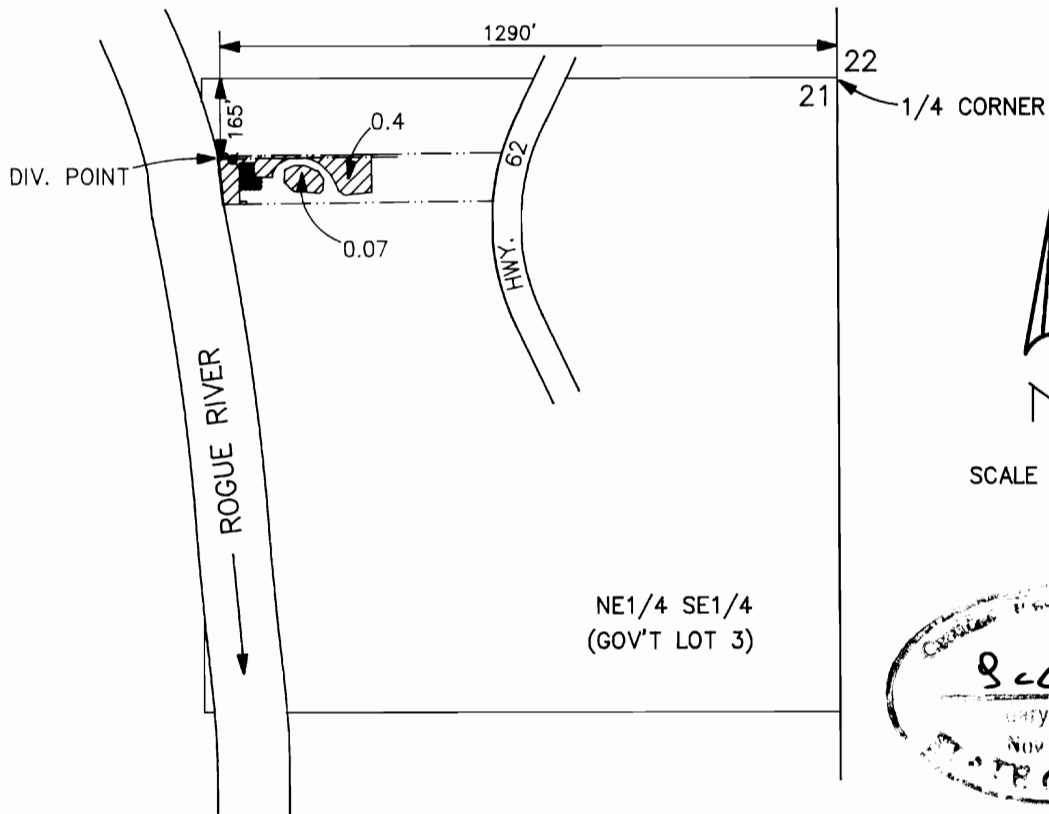

FINAL PROOF MAP

APPLICATION No. T-6574

IN THE NAME OF
WILLIAM L. MORSE

AND

YVONNE KAY MORSE

NOTE: MAP PREPARED FOR
WATER RIGHT PURPOSES ONLY,
NOT FOR PROPERTY BOUNDARY
LOCATIONS.

MAP PREPARED OCTOBER 5, 1998 BY GARY D. KAISER