T.2N.R.27E.W.M.

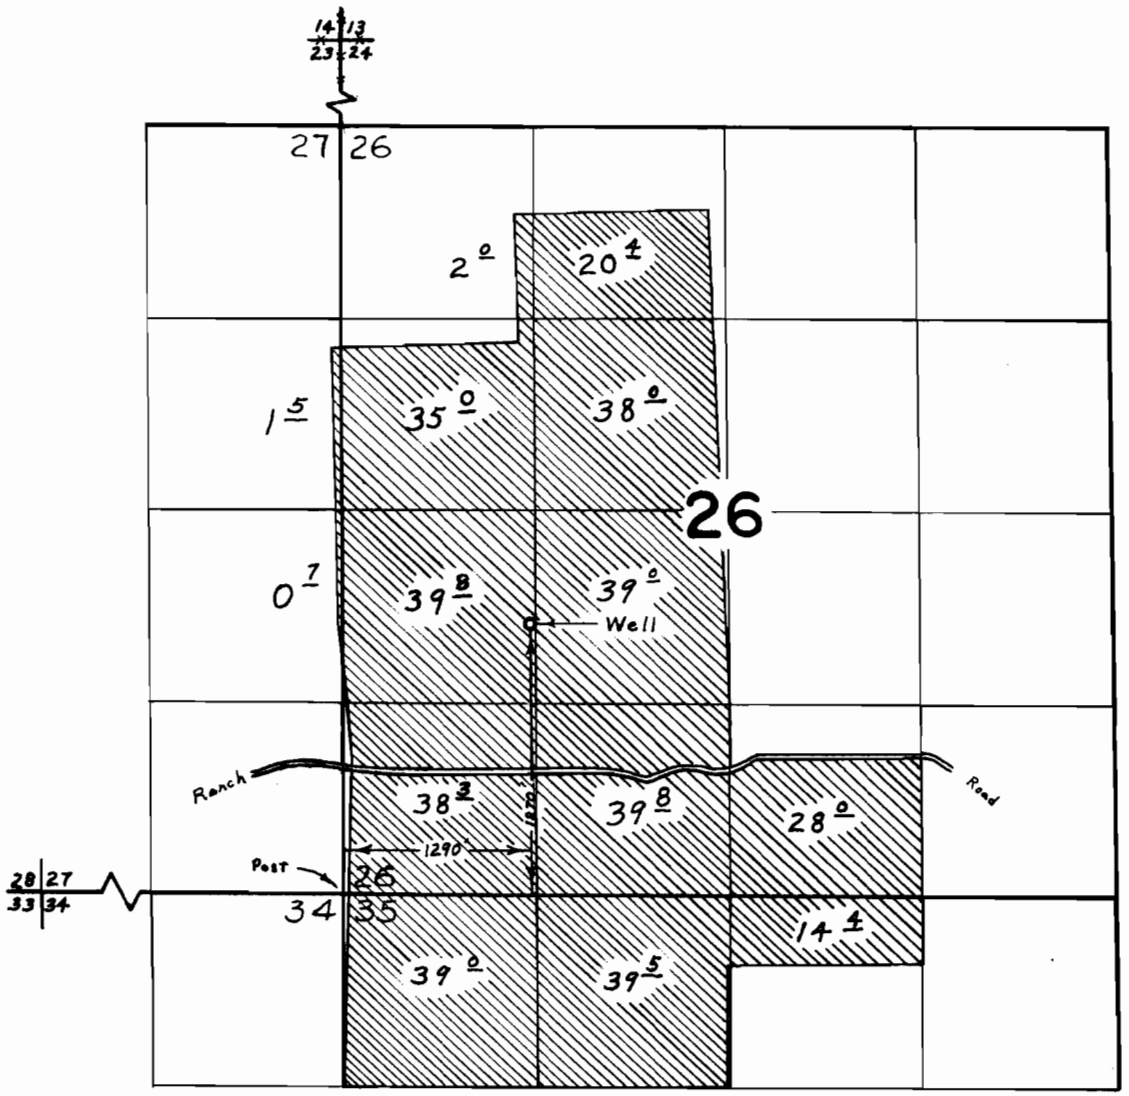

FINAL PROOF SURVEY
UNDER

Application No. G-2461 Permit No. G-2276
IN NAME OF

GLENN L. BEAN, RUTH B. KIMBALL & W. L. MINNICK

Surveyed Aug. 5 1966, by L. E. Gould
June 28 1967

1966-U
1967-U