








FINAL PROOF SURVEY AND CLAIM OF BENEFICIAL USE
SW 1/4, SW 1/4 & SE 1/4, SW 1/4, SECTION 34, T2N, R32E
APPLICATION G-11777 PERMIT G-10905
IN NAME OF EDNA BLOOM

RECEIVED
 SEP 28 1993

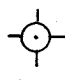
WATER RESOURCES DEPT.
 SALTM., OREGON

LEGEND

-  = AREA UNDER IRRIGATION SW 1/4, SW 1/4 S34. 3.10 ACRES
-  = AREA UNDER IRRIGATION SE 1/4, SW 1/4 S34. 0.56 ACRES
-  = SECTION CORNER = 1/16 TH LINE
-  = WELL
-  = WATER METER
-  = BURIED WATER DISTRIBUTION LINE
-  = RISER & SPRINKLER HEAD

AREA BENEFICIALLY IRRIGATED


SW 1/4, SW 1/4 S34: 3.10 ACRES
 SE 1/4, SW 1/4 S34: 0.56 ACRES
TOTAL: 3.66 ACRES

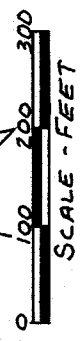

WELL IS LOCATED 325' NORTH & 800' EAST OF SW CORNER, SECTION 34, T2N, R32E, W.M.


SW 1/4, SW 1/4 S34

SE 1/4, SW 1/4 S34

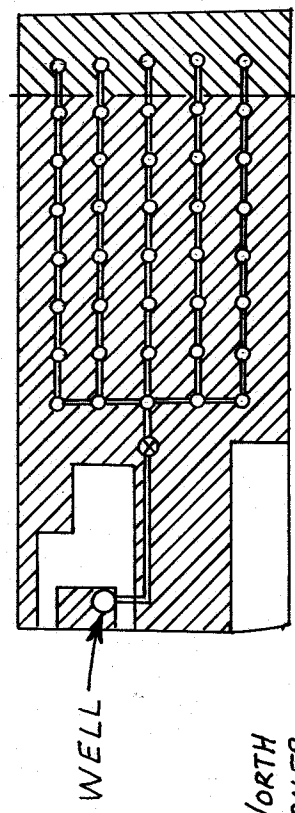

S33 | S34
 54 | 53
 T2N
 T1N

THIS MAP IS PREPARED FOR THE EXPRESS PURPOSE TO SHOW WATER APPROPRIATION AND USE. IT IS NOT INTENDED TO SHOW OR LOCATE PROPERTY OWNERSHIP LINES.

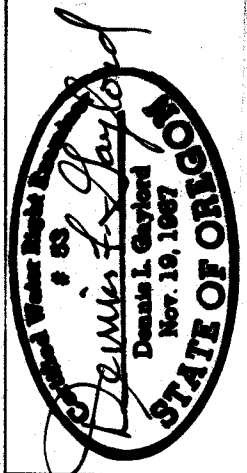

DENNIS L. GAYLORD
 4107 S.W. LAKE DRIVE
 PENDLETON, OR 97801
 503-276-6260
 CWRE No.53 9-18-93

G-10905 76324