


T. 37 S., R. 2 W., W.M.

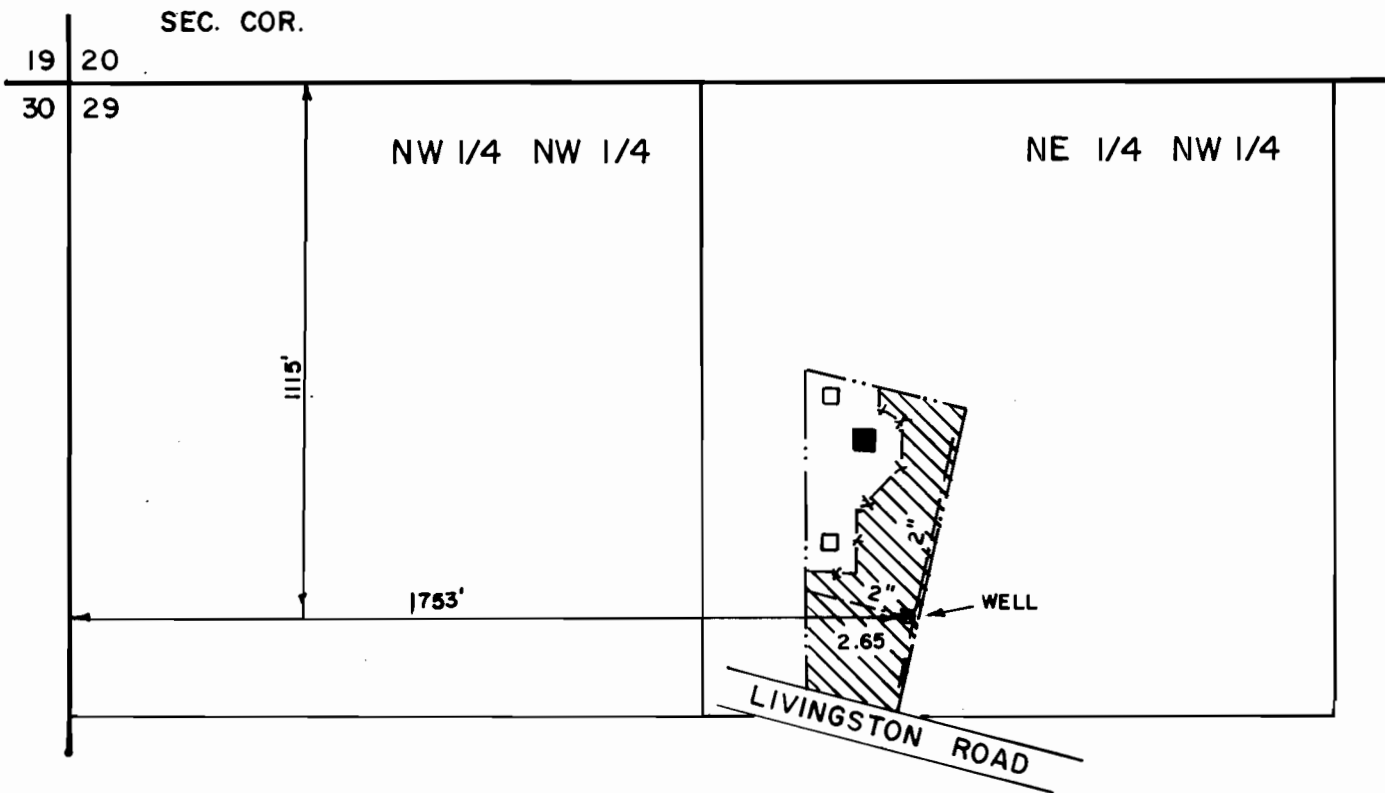

FINAL PROOF MAP

APPLICATION No. G-11964

PERMIT No. G-11043

IN THE NAME OF
RODNEY A. WITHAM

MAP PREPARED SEPTEMBER
26, 1994 BY GARY D. KAISER

NOTE: MAP PREPARED FOR WATER
RIGHT PURPOSES ONLY, NOT FOR
PROPERTY BOUNDARY LOCATIONS.

SCALE: 1" = 400'

