



# Township 6 South, Ranges I West & I East, W. M.

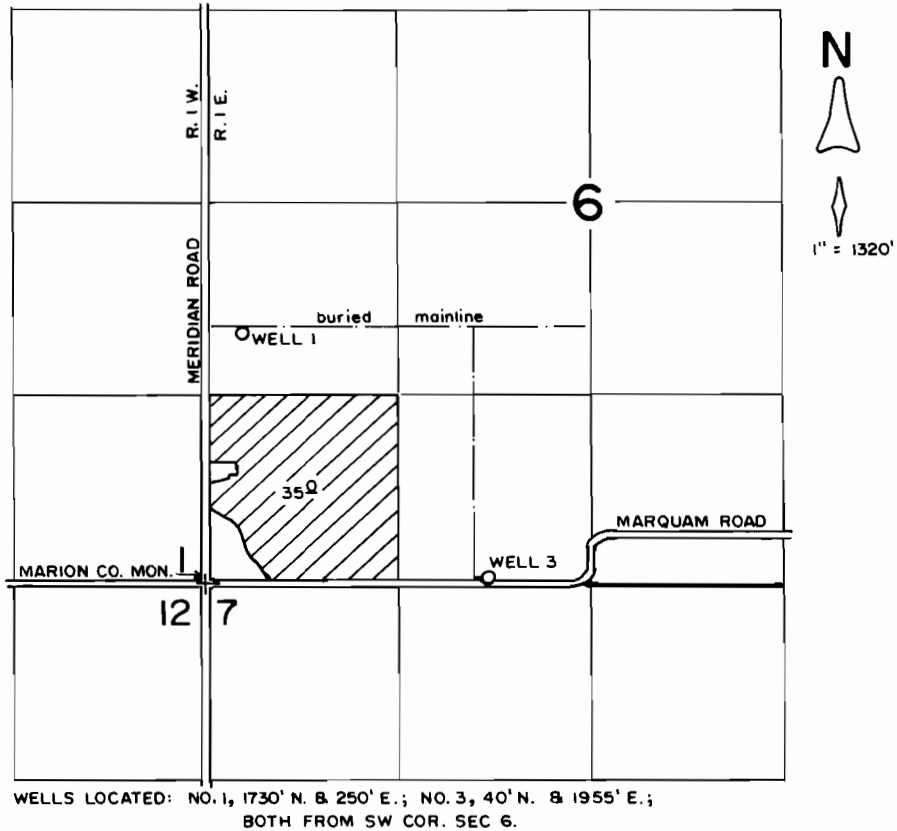

FINAL PROOF SURVEY  
under  
Appl. No. G-13378, Per. No. G-12597  
in name of  
GOSCHIE FARMS, INC.  
Apr. 17, 1998

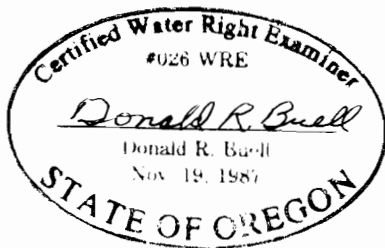

THIS MAP WAS PREPARED FOR THE PURPOSE OF IDENTIFYING THE LOCATION OF A WATER RIGHT ONLY AND IS NOT INTENDED TO PROVIDE LEGAL DIMENSIONS OR LOCATION OF PROPERTY OWNERSHIP LINES.