


Per 7660  
7433

Canyon City, Grant Co. Oregon.  
Map of Johnson Ditch

Michael Spears (Citizen)  
drew plat.

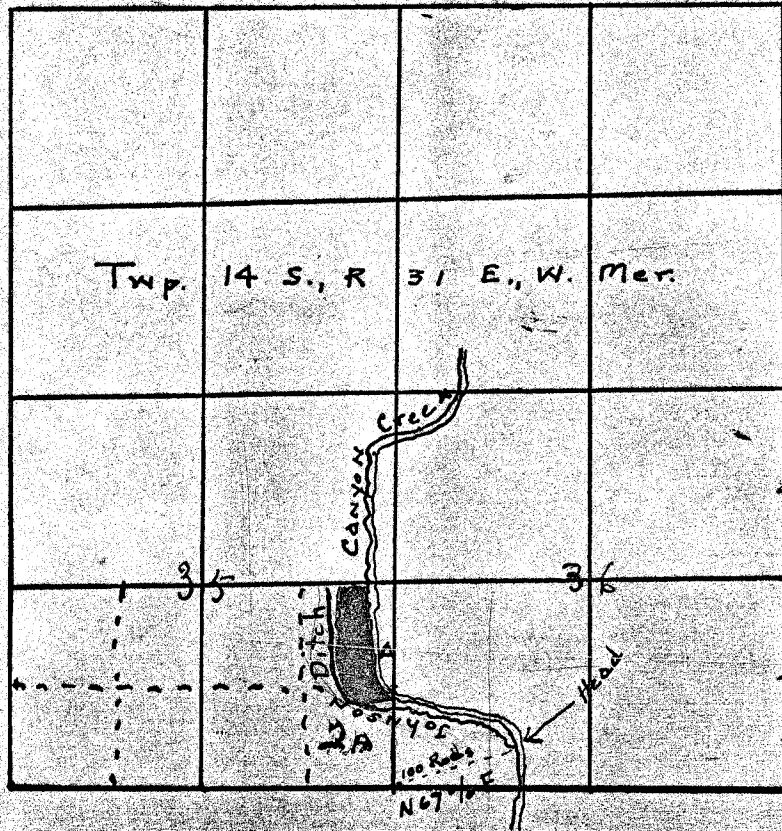

Application No. 11172  
Permit No. 7660