

FINAL PROOF SURVEY


~ for ~

RAYMOND RAVELLI

T. 4 S, R. 1 E, W.M.



Scale: 1" = 400'

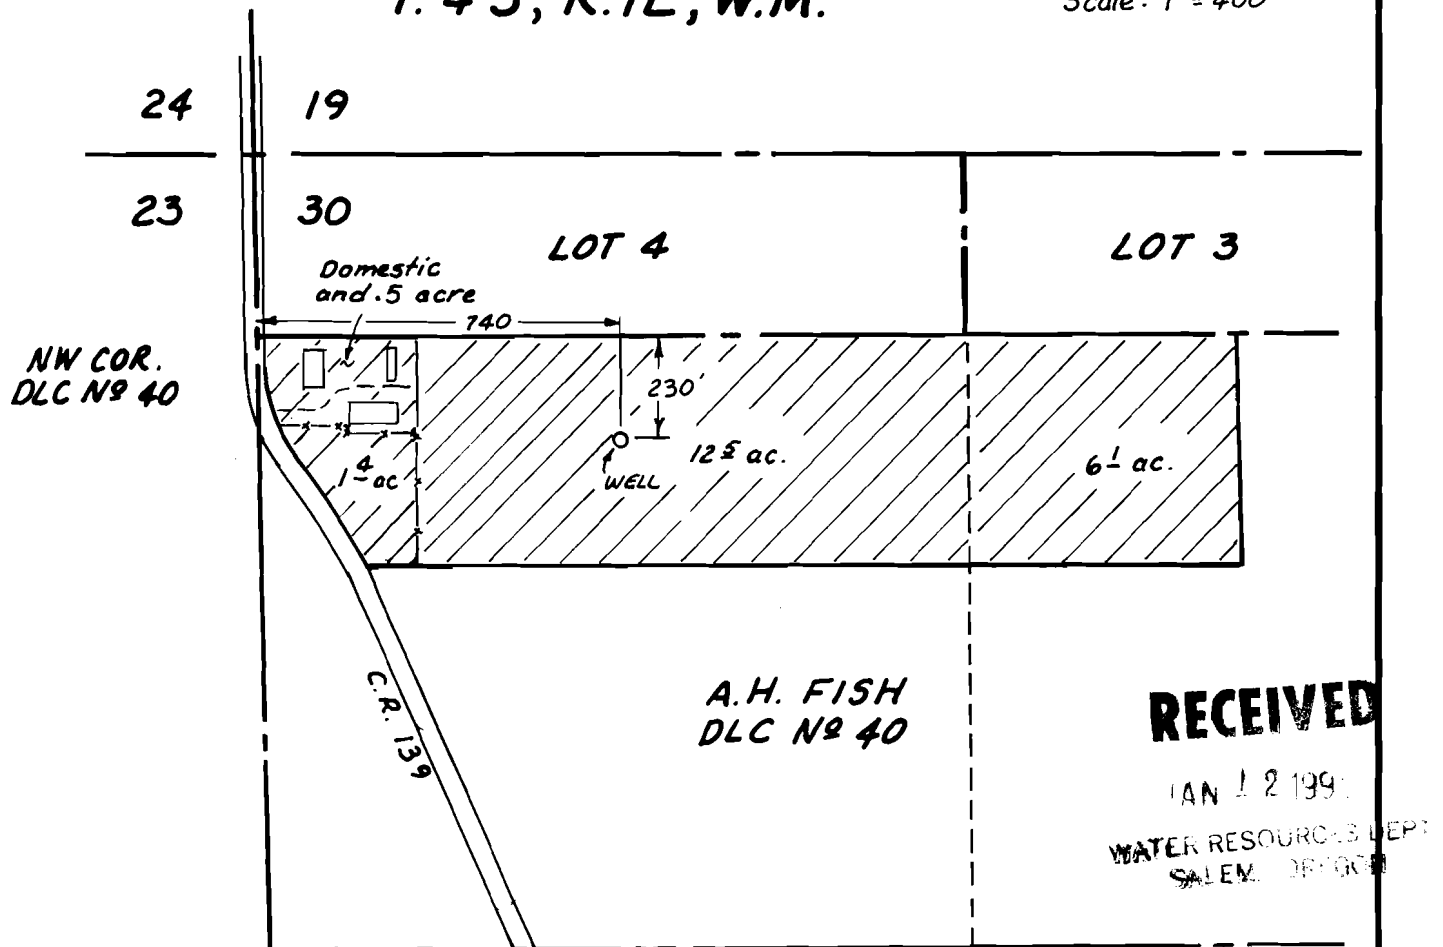

Applicant:


RAYMOND RAVELLI
5605 SE MONROE
MILWAUKIE, OR 97222

SW 1/4, NW 1/4 = 14 1/2 ac.
SE 1/4, NW 1/4 = 6 1/2 ac.

Prepared By:

LAWRENCE ANDERSON
112 N. SPRINGBROOK RD.
NEWBERG, OR 97132

This map was prepared for the purpose of locating water rights and is not intended to define property boundaries.

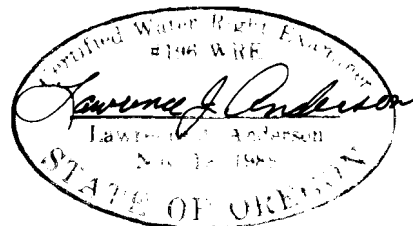

DECEMBER 1993