


C-7633b

TOWNSHIP 16 SOUTH, RANGE 11 EAST, W.M.

RECEIVED

JUL 09 1999


WATER RESOURCES DEPT.
SALEM, OREGON

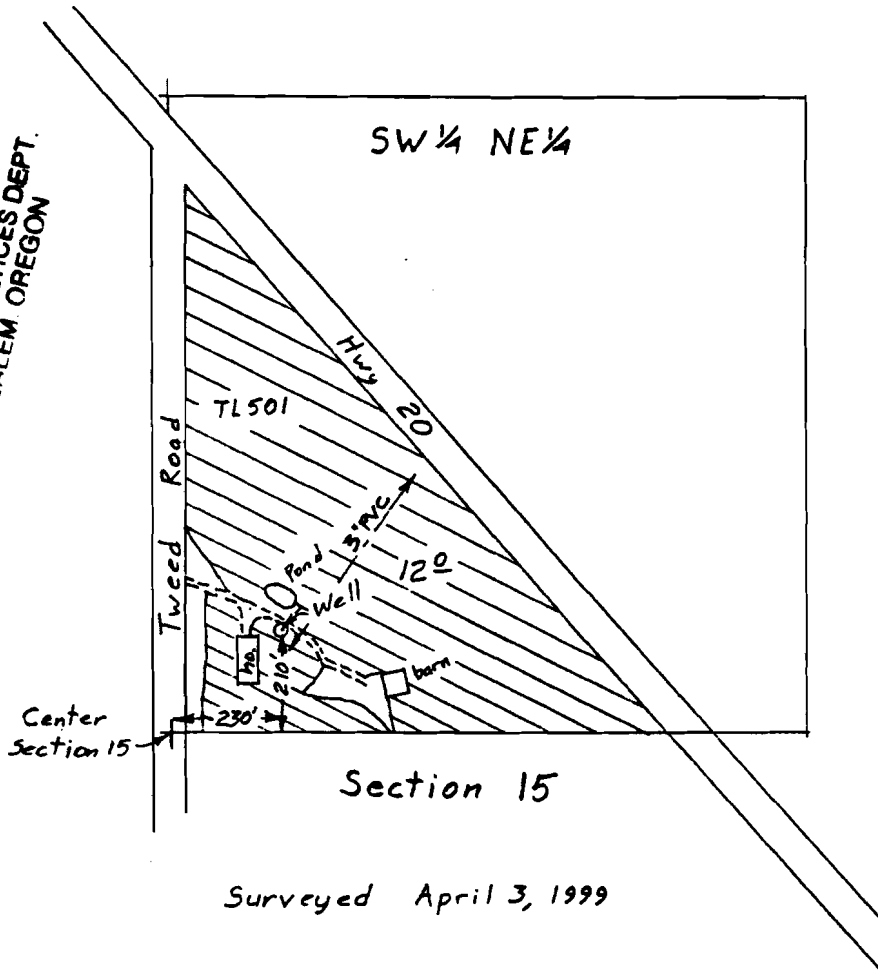

Surveyed April 3, 1999

Application G-14484
Permit G-13310

Claim of Beneficial Use Map
for
DAVID BRUCE NOE

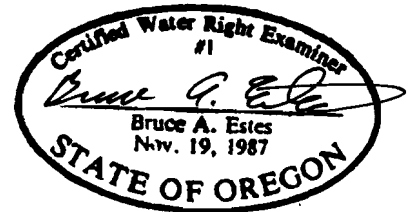

This map is for the purpose of locating a water right only and has no intent to provide legal dimensions or the location of property lines.

ESTES SURVEYS
 6293 Sunnyview Rd. NE Salem, OR 97305 (503) 585-7593
 60382 Arnold Rd. Bend, OR 97702 (503) 382-7391

G-13310