


Located in the NE1/4 of the SW1/4  
 Section 30 Township 24S Range 11W W.M.  
 Coos County

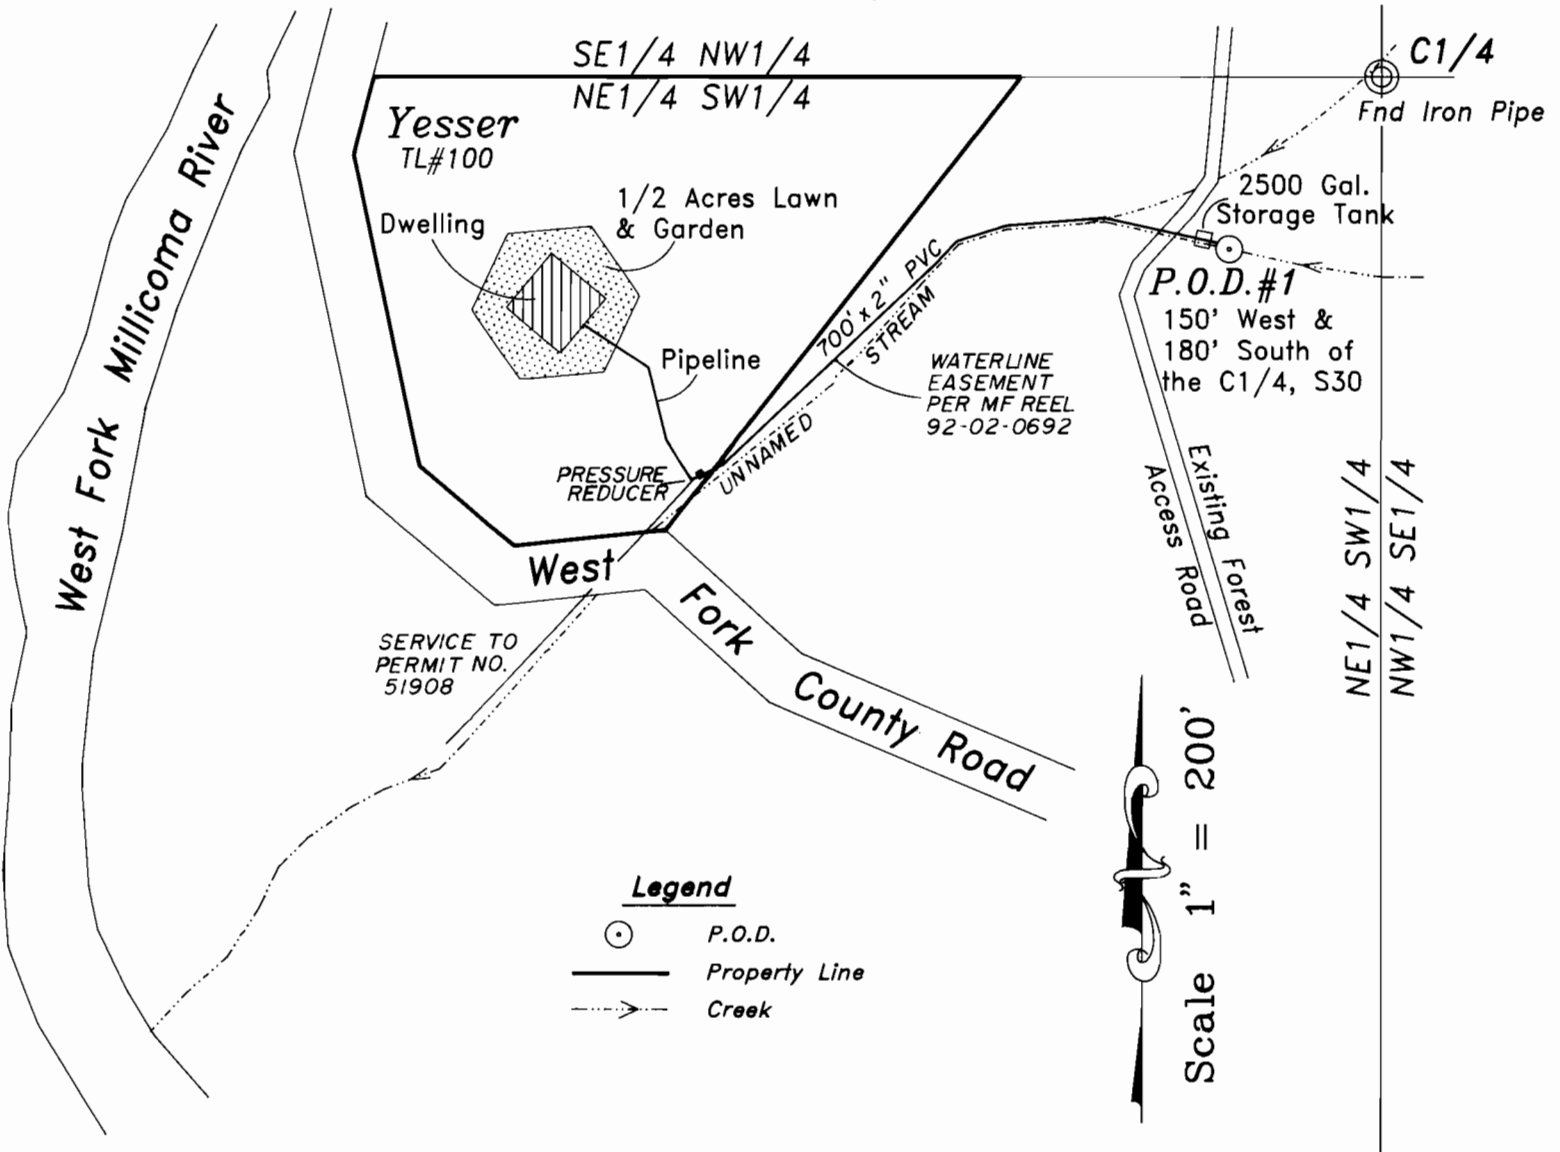


- Legend**
- P.O.D.
  - Property Line
  - > Creek

Scale 1" = 200'

**EXAMINERS DISCLAIMER STATEMENT**

The preparation of this map was for the purpose of identifying the location of the Water Right only and has no intent to provide dimensions or location of property ownership lines.

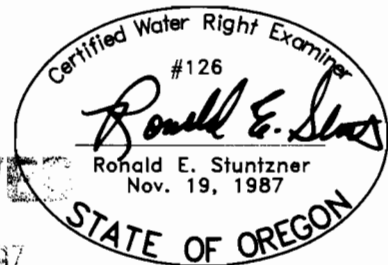

RECEIVED

FEB 5 1997

WATER RESOURCES DIVISION  
 SALEM OREGON

**FINAL PROOF SURVEY**

IN THE NAME OF

Paul & Vikki Yesser

Application No. S-72252

Permit No. 52294

Surveyed on August 10, 1992 by R.E. Stuntzner