

BENEFICIAL USE MAP

IN THE NAME OF: BARBARA E. RYAN
TAX LOT 2600, SE1/4 S32, T29S, R12W

RECEIVED

JUL 30 1999


WATER RESOURCES DEPT.
SALEM, OREGON

CENTER 1/4

1 INCH = 400 FEET

1/4 COR. SECS. 32 & 33

THE POINT OF DIVERSION IS 477 FT.
NORTH AND 958 FT. WEST FROM THE
SEC. COR. OF SECTIONS 4, 5, 32 & 33

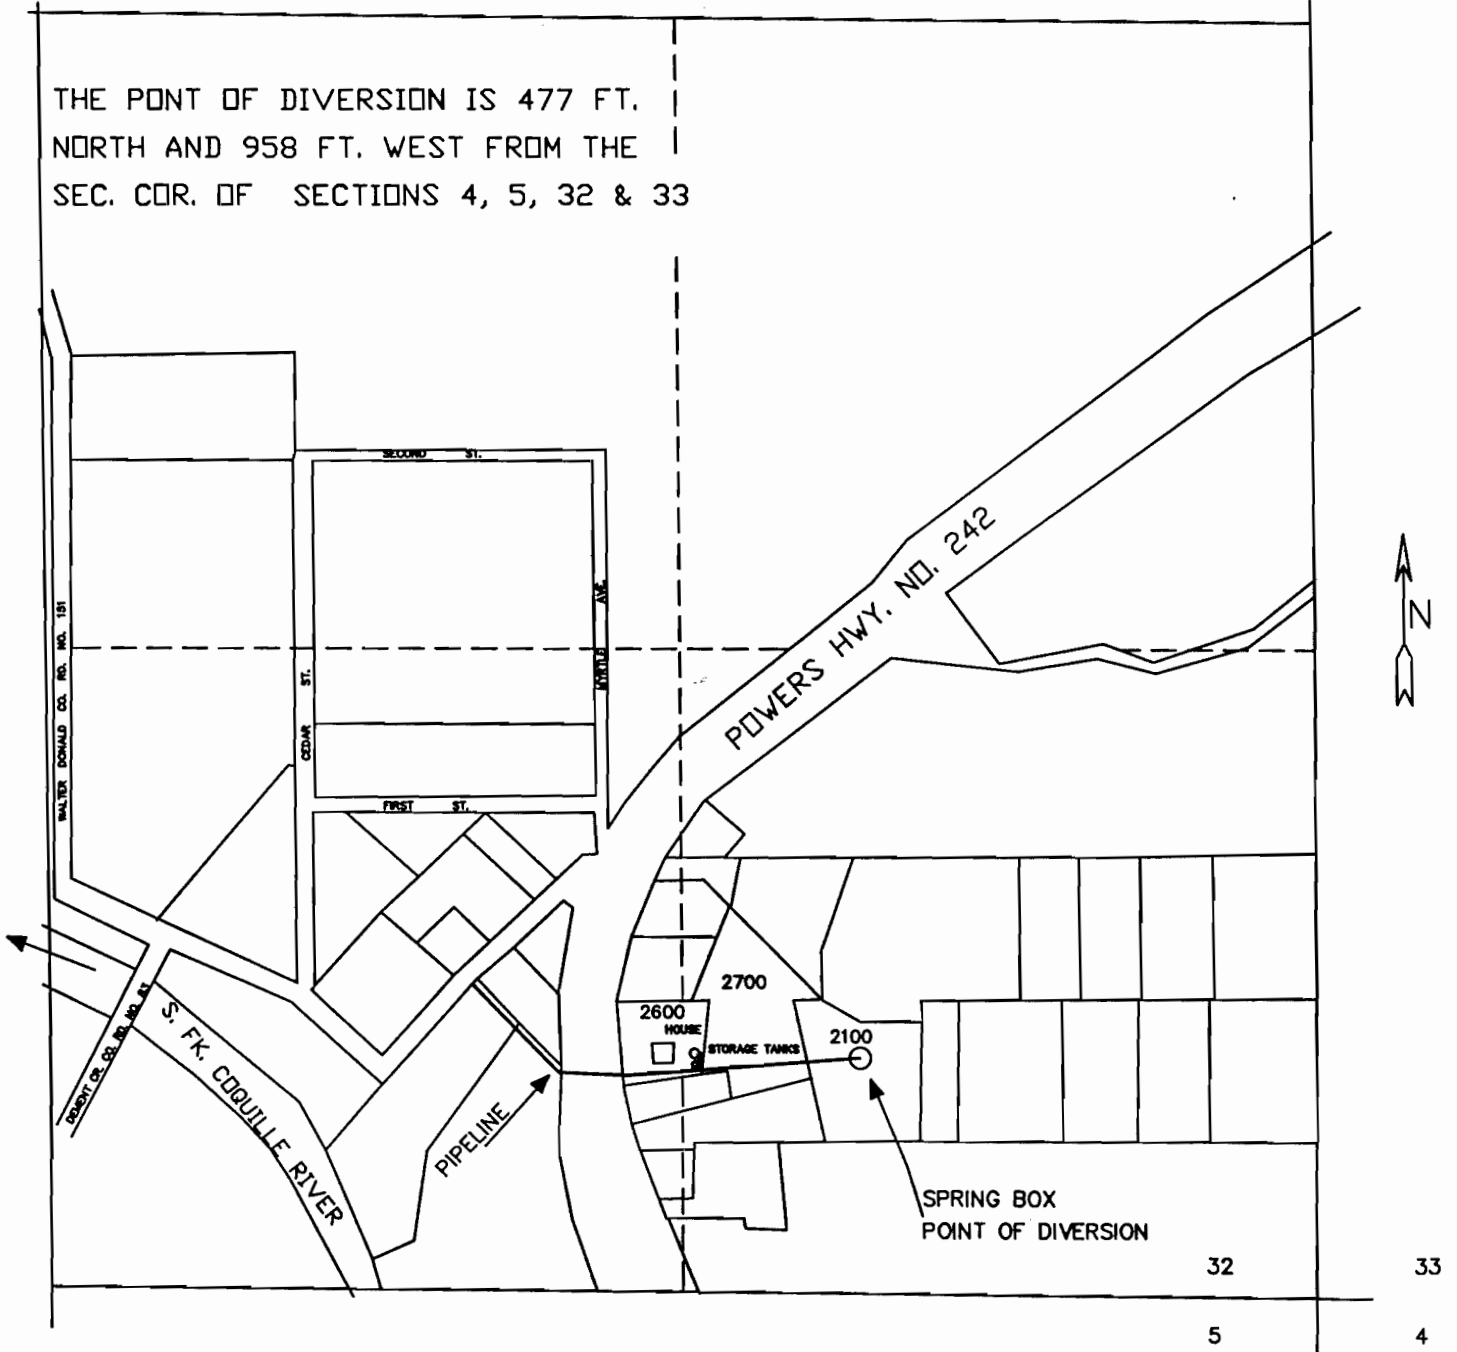

THE PURPOSE OF THIS MAP IS TO IDENTIFY THE
LOCATION OF THE WATER RIGHT. IT IS NOT INTENDED
TO PROVIDE INFORMATION RELATIVE TO THE
LOCATION OF PROPERTY OWNERSHIP BOUNDARY LINES.

SURVEYED APRIL 3, 1999

APPLICATION FILE NO.: S-83822

PERMIT NO.: 53541

Barbara E. Ryan
4/18/99