G-5205

76341

# T.36S. R.11E. W.M.

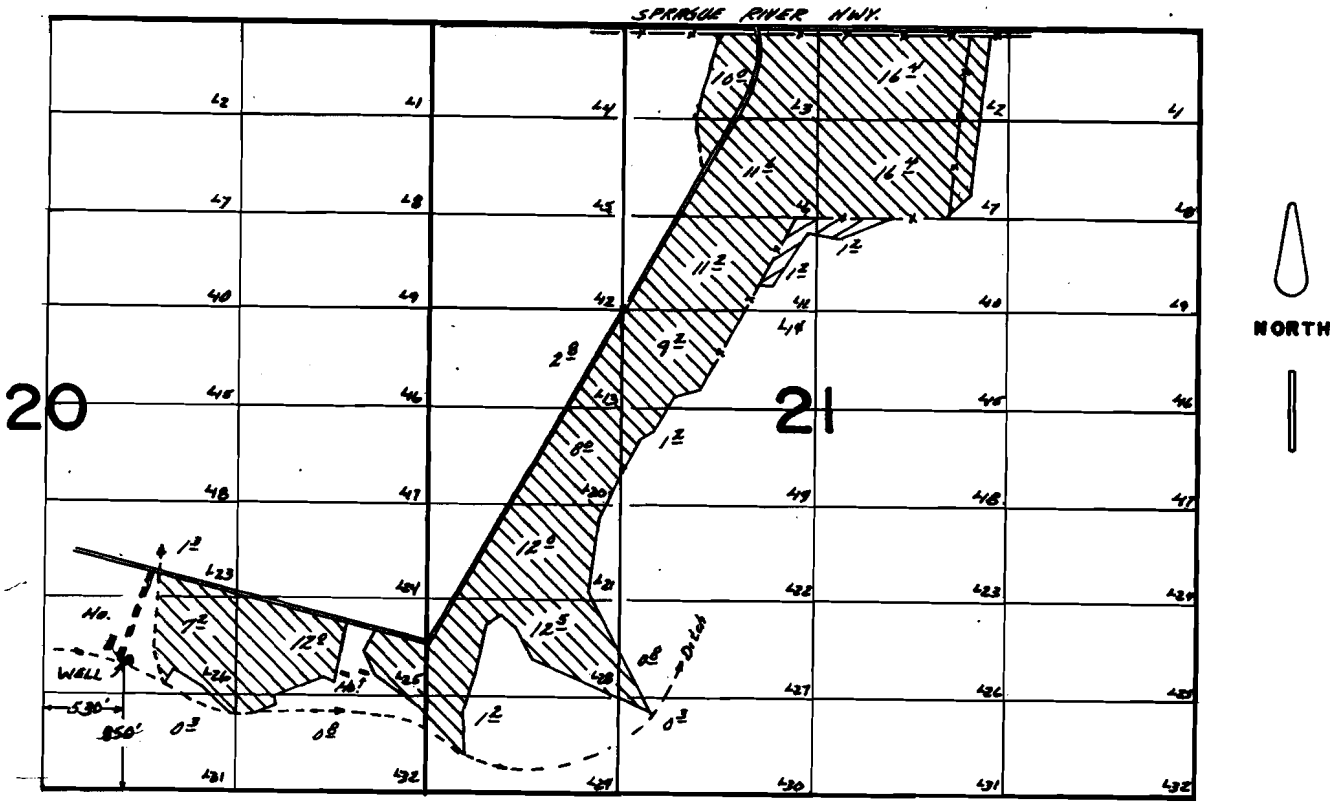


Sprague Riv. Wells

## FINAL PROOF SURVEY

UNDER

Application No. G-6401 G-6402 Permit No. G-5205 G-5206

IN NAME OF

Robert E. Bartell Jr. & Darla Bartell

Surveyed Sept. 23 19 79, by C.R. RODRIGUEZ

CWO-76K-112 & PTS-1979CR