


G-5206
76342

T.36S. R.IIE.W.M.

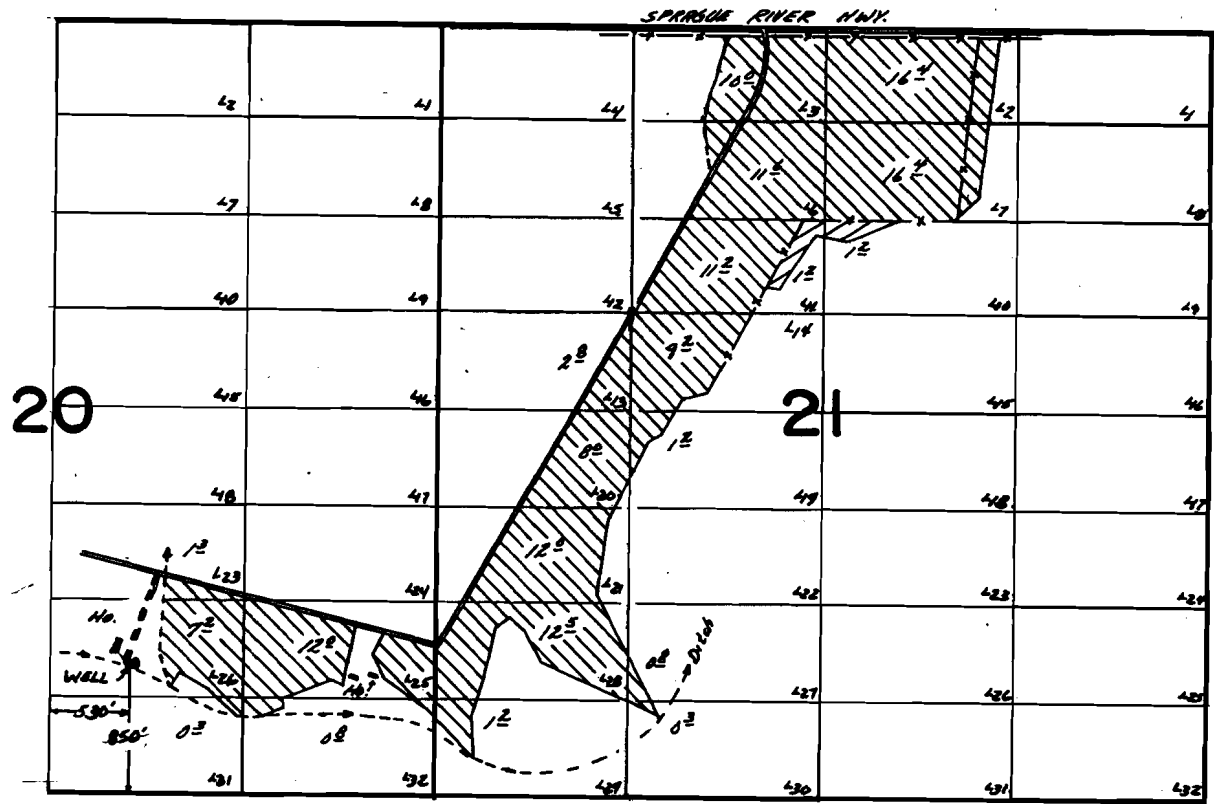

Spring Riv. Wells

FINAL PROOF SURVEY UNDER

Application No. G-6401 G-5205
G-6402 Permit No. G-5206
IN NAME OF



Robert E. Bartell Jr. & Darla Bartell

Surveyed Sept. 23, 1979, by C.R. RODRIGUEZ.