



T.1N. R.13E. W.M.

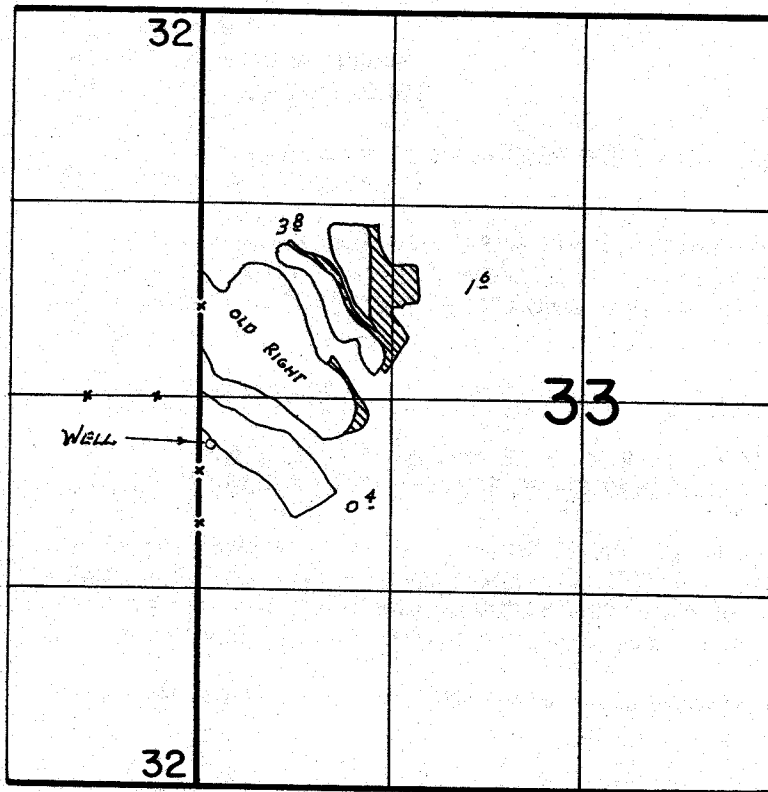

WELL LOC. 310' S & 78' E FROM THE W 1/4 COR SEC. 33

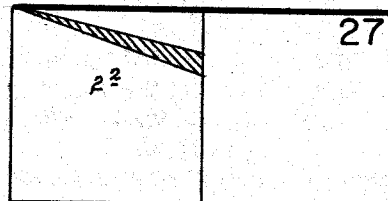

FINAL PROOF SURVEY
UNDER

Application No. G-8639 Permit No. G-8293
IN NAME OF

C. & F. ORCHARDS

Surveyed Nov. 28 1983, by T. J. Paul