


T. 1S., R. 16E., W. M.

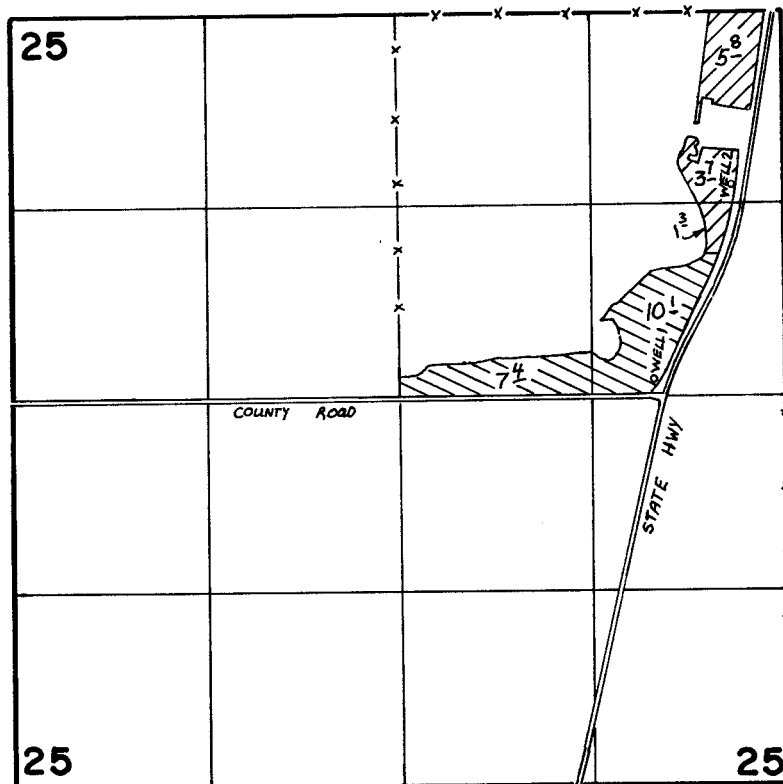

WELL 1 LOCATED 2500'S & 910' W. FROM NE COR. SECTION 25
WELL 2 LOCATED 1180'S & 360' W. FROM NE COR. SECTION 25

SCALE: 1" = 1320'

FINAL PROOF SURVEY

UNDER

Application No. **G-8902** Permit No. **G-8354**
G-9892 **G-9712**
IN NAME OF

BAR 97 RANCH

Surveyed May 6, 1985, by V. L. Church