


# T.35S., R.5W., W.M.

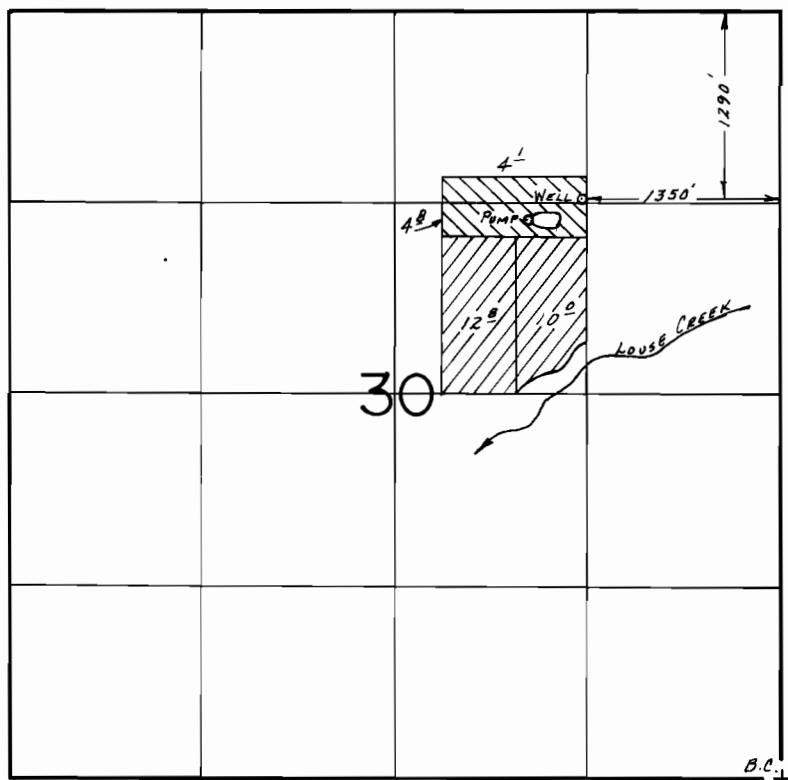

 PRIMARY  
 SUPPLEMENTAL

SCALE: 1"=1320'

## FINAL PROOF SURVEY UNDER

Application No. G:10513 Permit No. G:9714.....  
IN NAME OF

.....DAVID J. CASH.....

Surveyed July 10, 1984, by B.S. JAMES.....