


# T.30 & 31 S., R.42 E., W.M.

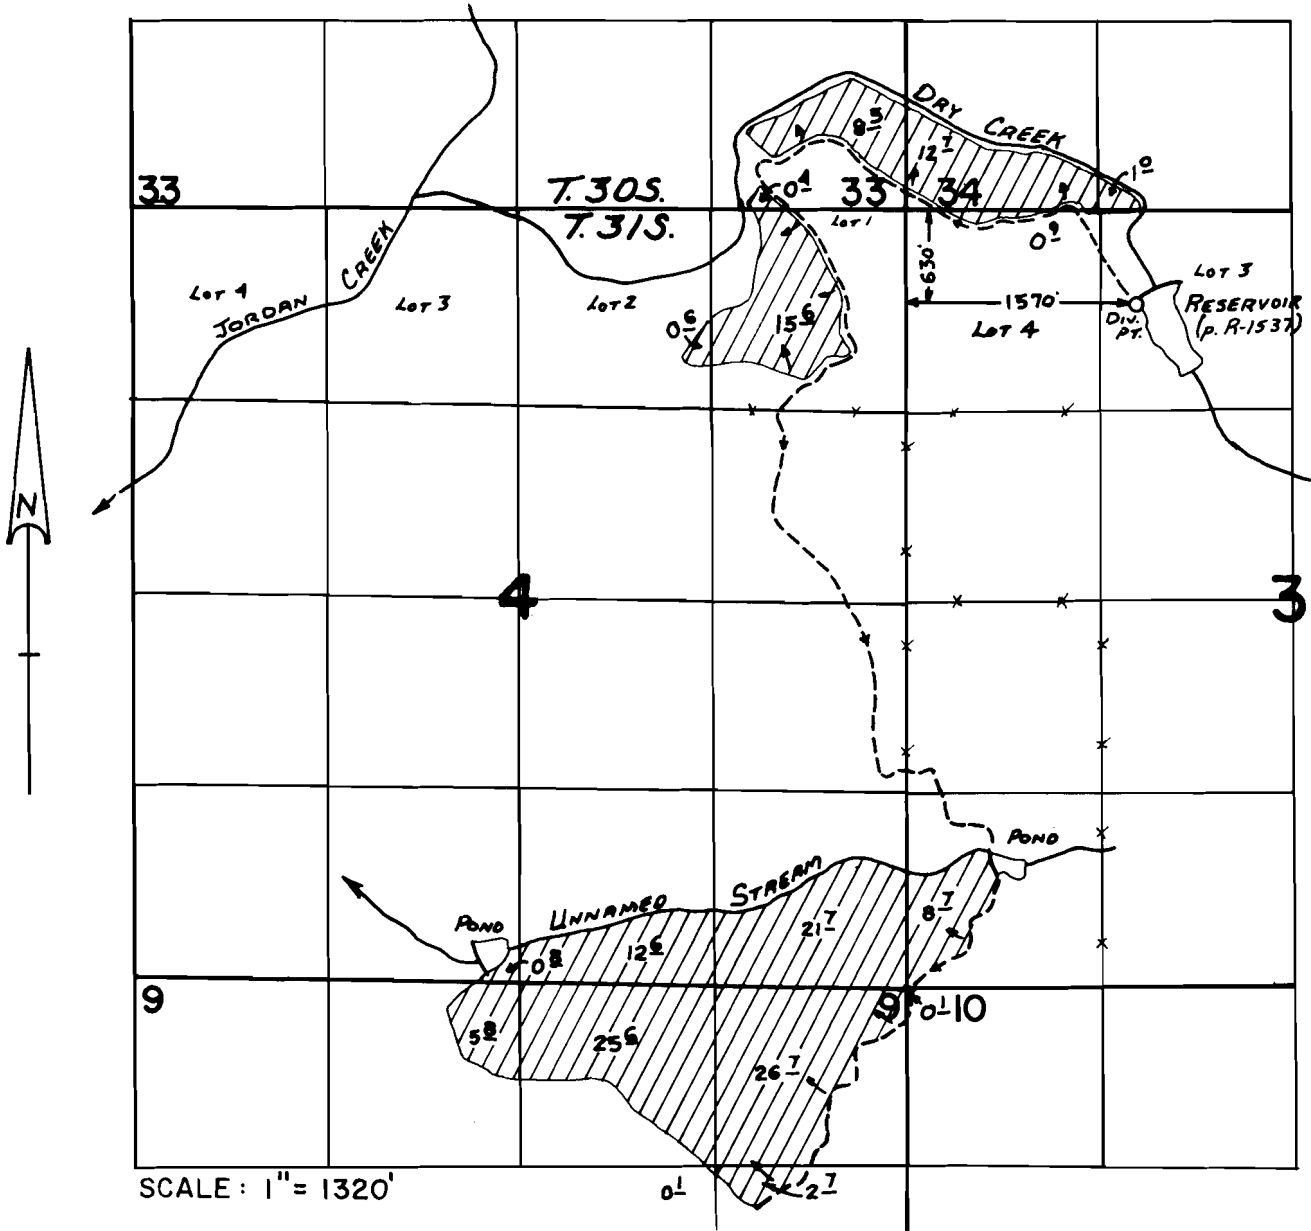

## FINAL PROOF SURVEY UNDER

Application No. 41963 Permit No. 31107  
IN NAME OF

RICHARD & MARGENE EIGUREN

Surveyed July 16 1985, by L.M. IOLL