



# T. 9S., R. 25E., W.M.

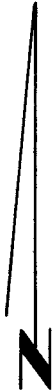

SCALE: 1"=1320'

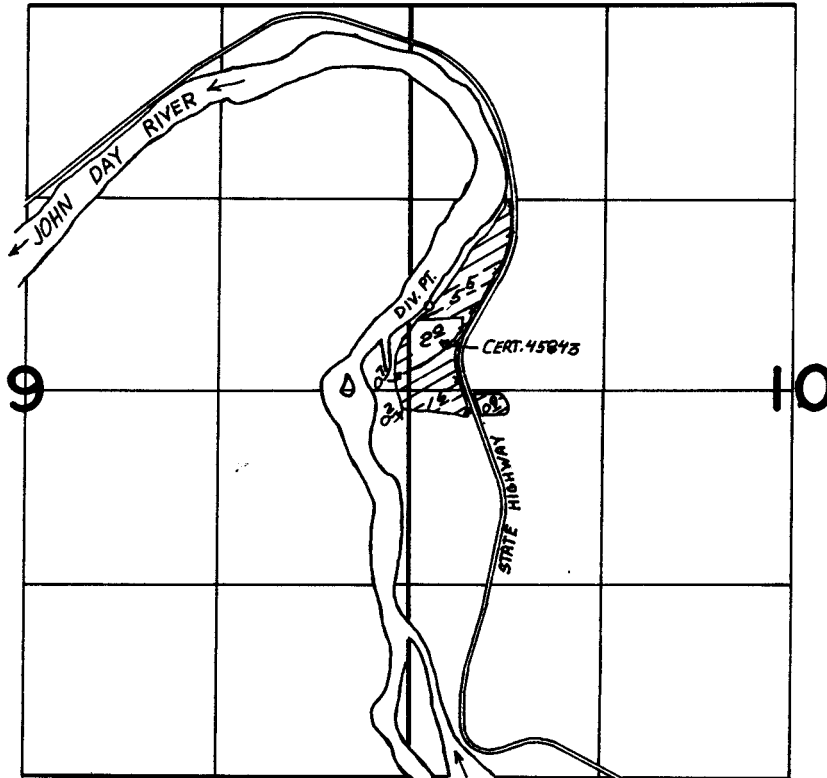

DIV. PT. LOCATED 690' N. AND 130' E. FROM W. 1/4 COR. SEC. 10

## FINAL PROOF SURVEY UNDER

Application No. 53149 Permit No. 38780.....

IN NAME OF

*Victor W. Doherty*

Surveyed APRIL 9, 1985., by V.L. CHURCH.....

*name revised 9/28/88*  
DOV-4W-176 J6