


T. 30 S., R. 6 W., W. M.

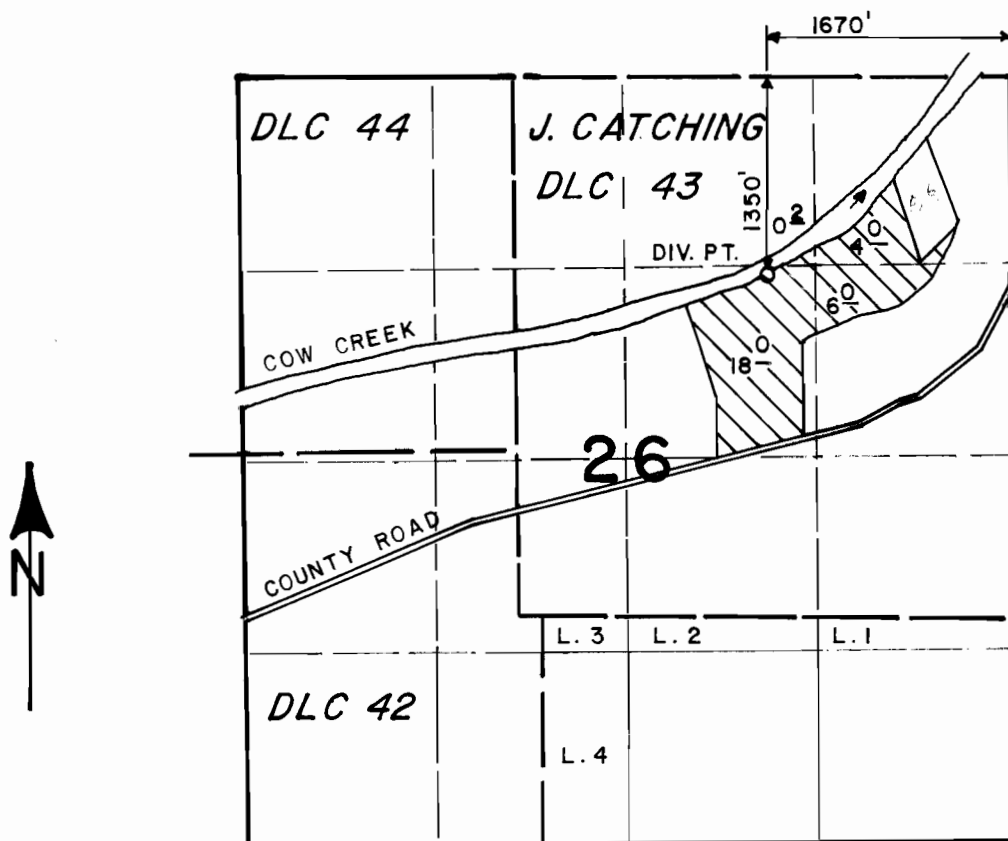

SCALE: 4" = 1 MILE

FINAL PROOF SURVEY
UNDER

Application No. 56724 Permit No. 42579
IN NAME OF

ROY D. SMITH

Surveyed JUNE 26, 1984, by L. E. CASHION