


# T.41S. R.13W. W.M.

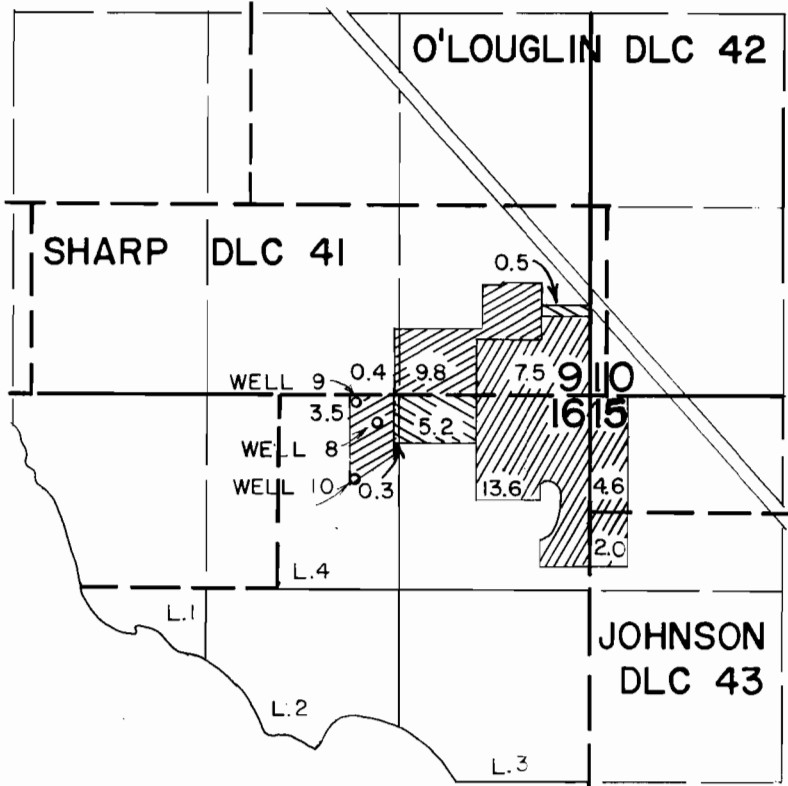

WELL 8-170' S. & 1440' W., WELL 9-20' S & 1590' W.,  
 WELL 10-570' S. & 1590' W., ALL FROM THE NE COR. SEC. 16

SCALE 1" = 1320'

## FINAL PROOF SURVEY UNDER



Application No. G-7684 Permit No. G-7156.....  
 IN NAME OF

OREGON PROPAGATING COMPANY

Surveyed APR. 9, 1985, by L.E. CASHION.....