


T.41S., R.13W., W.M.

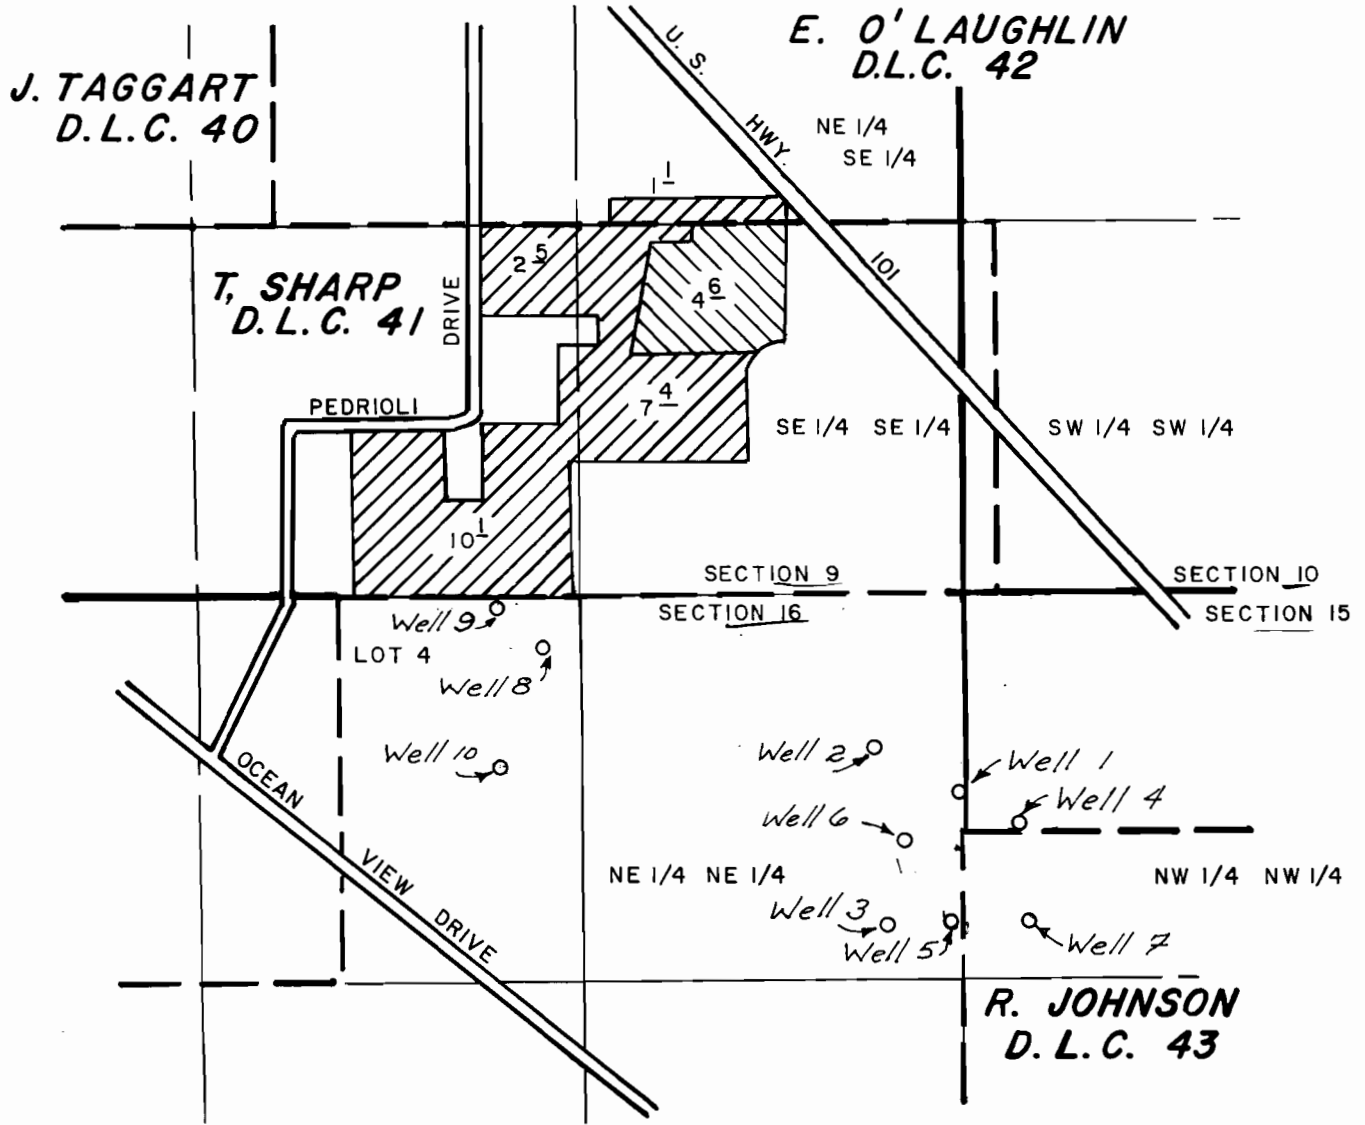

SCALE: 8" = 1 MILE

KEY:

-  PRIMARY IRRIGATION
-  SUPPLEMENTAL IRRIGATION

FINAL PROOF SURVEY UNDER



Application No. G-9569 Permit No. G-9493
IN NAME OF

OREGON PROPAGATING COMPANY

Surveyed APRIL 9 1985, by L. E. CASHION

Revised 9/24/78