

AJG 4 1957


WATER RESOURCES DEPT.
SYSTEM DIVISION

NE 1/4
NE 1/4

SW 1/4
SW 1/4

Also See
Reference File # S-72916

Pt. Div.
671' North
522' East
SW Corner
Section 18

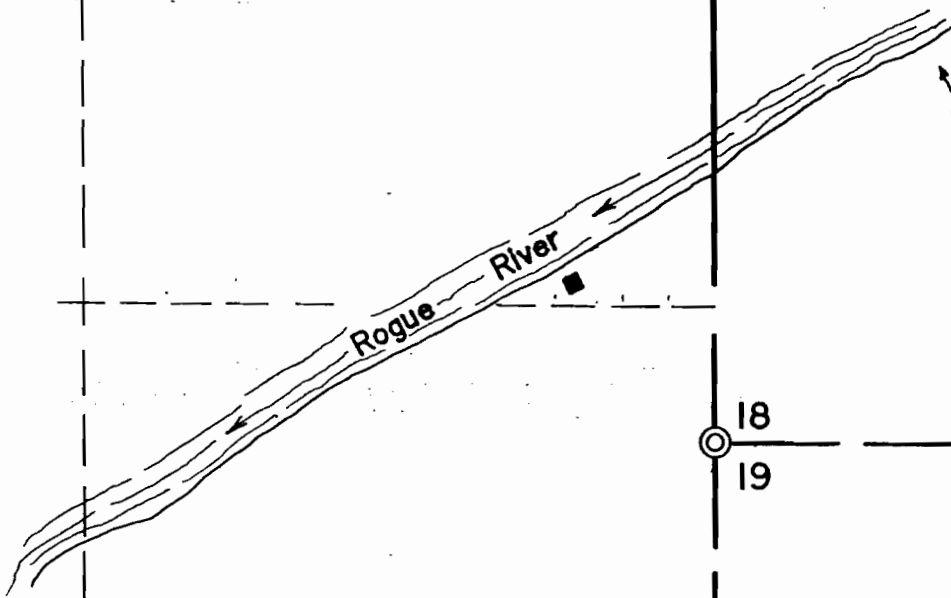

SE 1/4
NE 1/4

T 33 S, R 10 W
T 33 S, R 11 W

NW 1/4
NW 1/4



The preparation of this map was for the purpose of identifying the location of the proposed water right and has no intent to provide dimensions or location of property lines.

FINAL PROOF SURVEY for GARY KERR

Located in the SW 1/4, SW 1/4, Section 18,
T 33 S, R 10 W, W.M.,
Curry County, Oregon

Scale - 1" = 400' May, 1997

Application No. 72867

Permit No. 52533

Donald Cormack
C.W.R.E. # 29
P.O. Box 1280
Brookings, Oregon 97415

