


T. 28 S. R. 14 & 15 E. W.M.

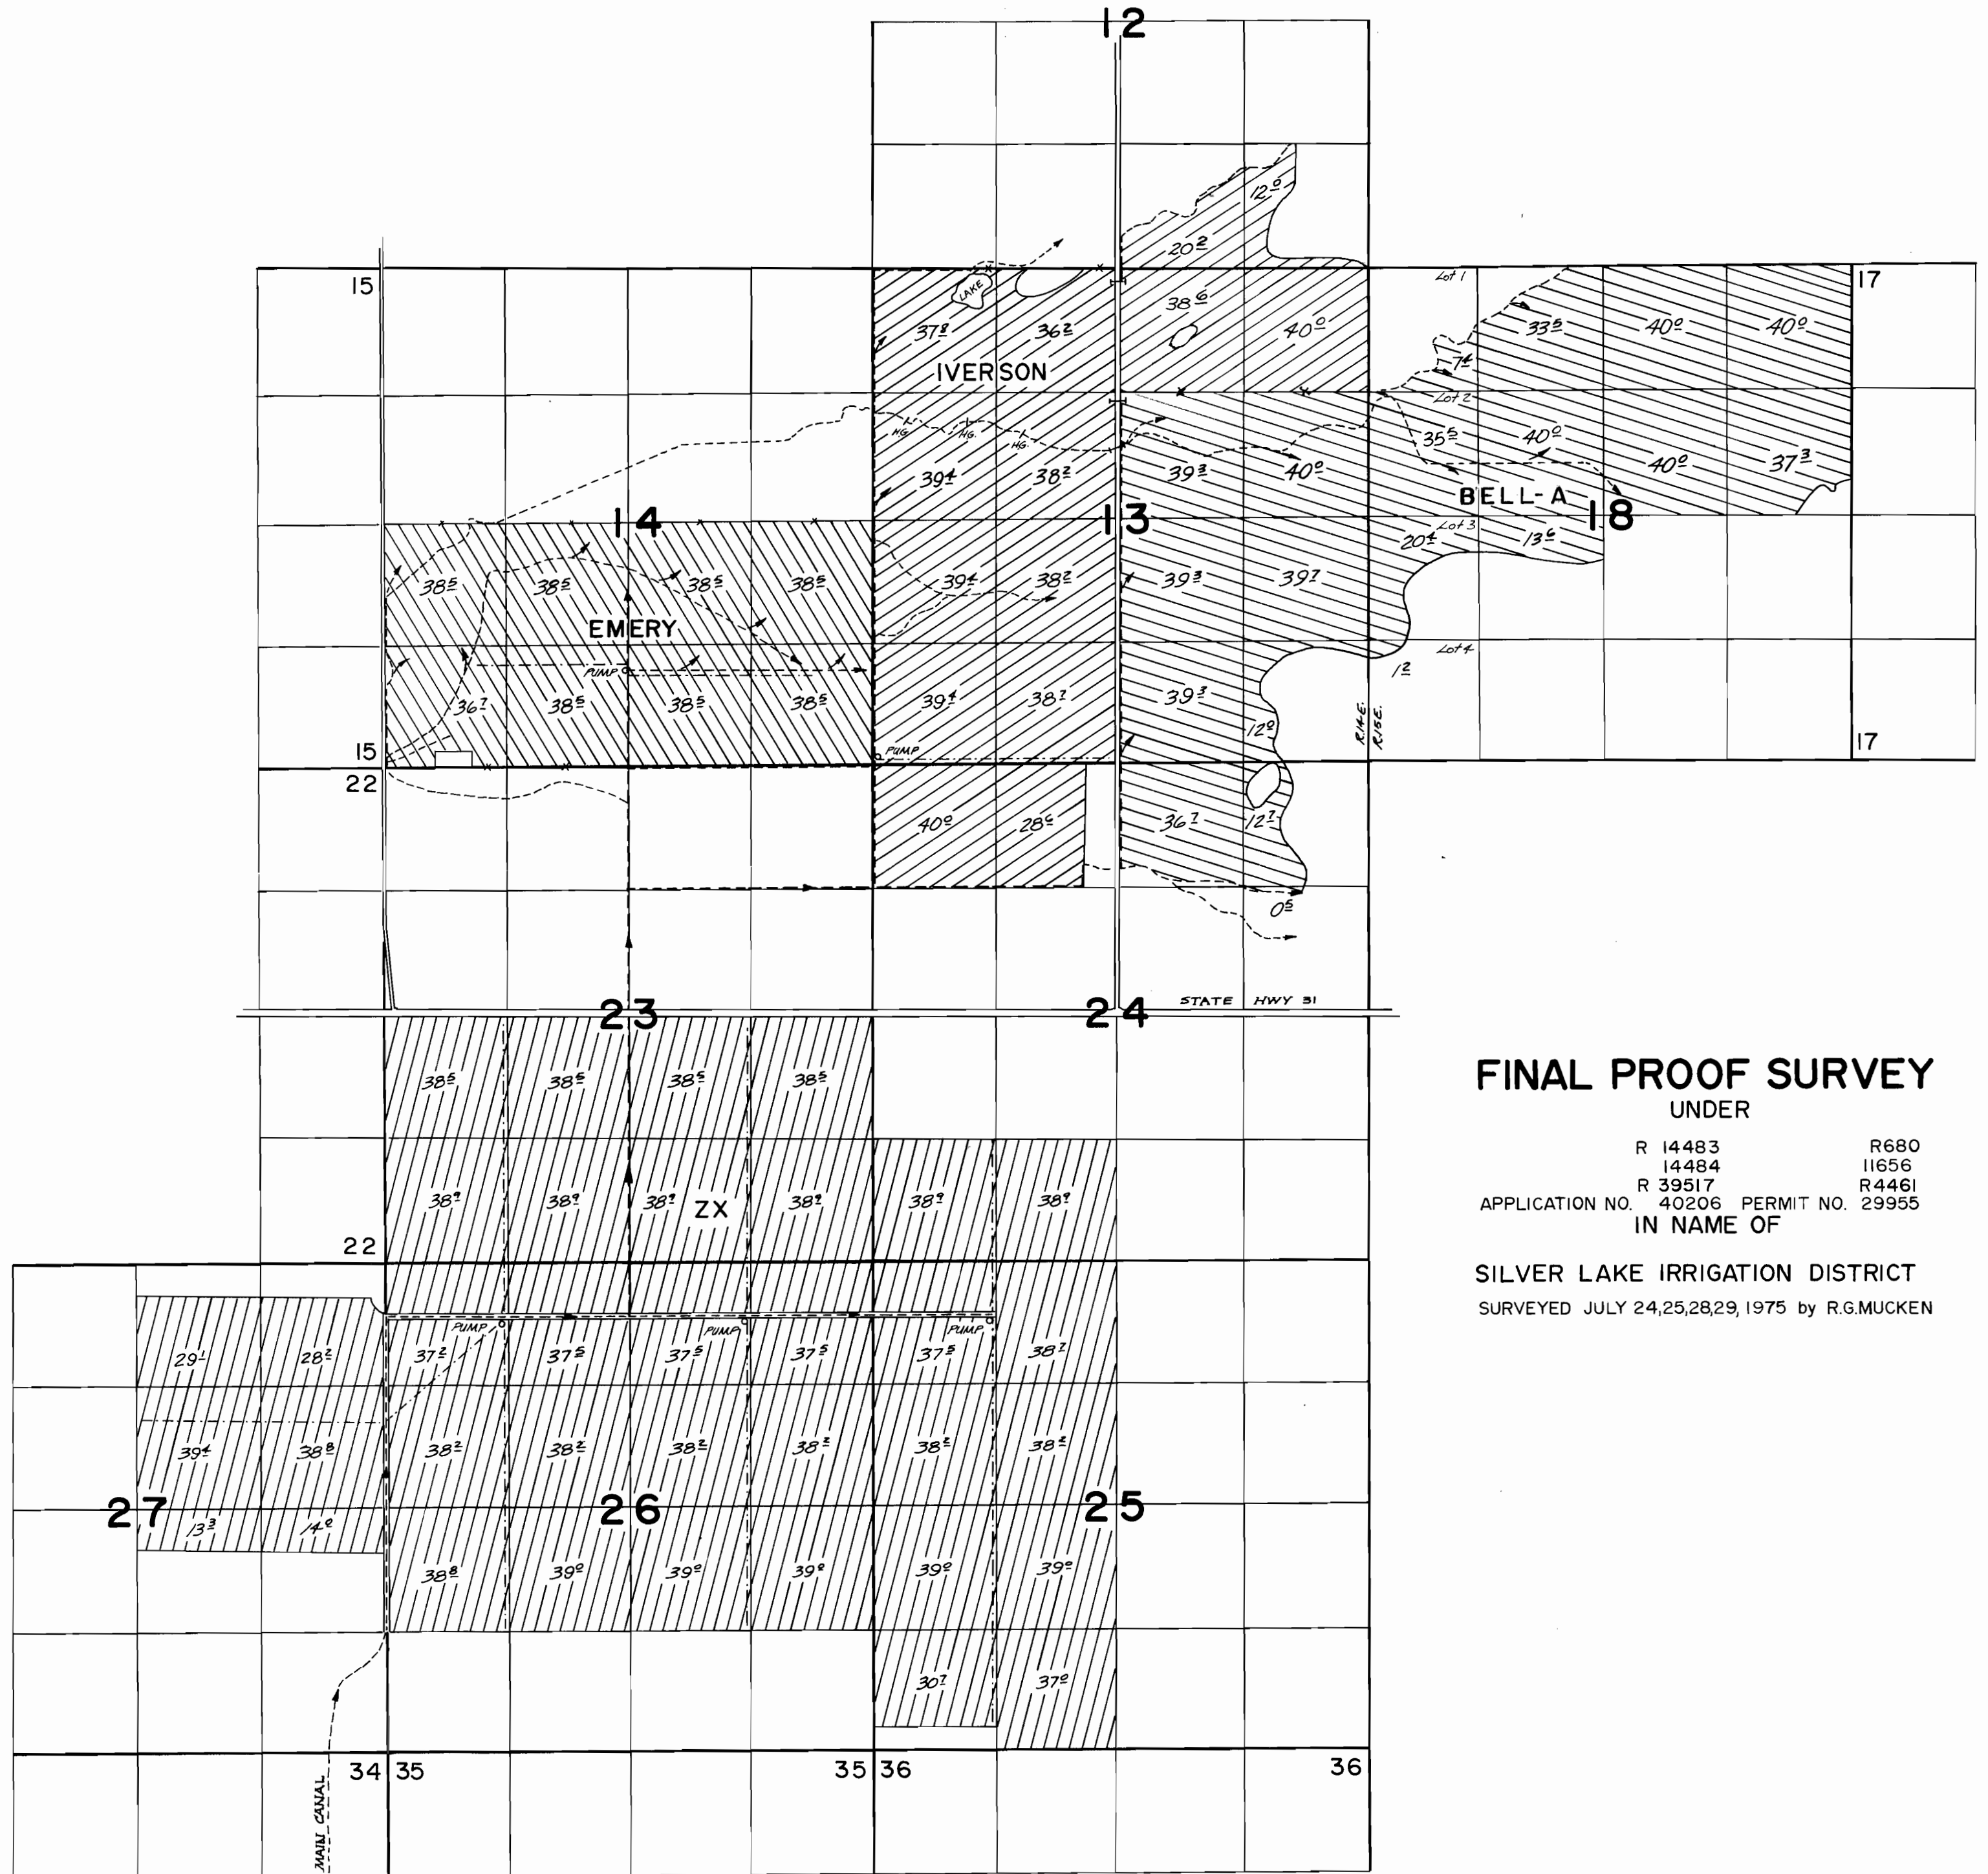

FINAL PROOF SURVEY
UNDER

R 14483 R680
14484 11656
R 39517 R4461
APPLICATION NO. 40206 PERMIT NO. 29955
IN NAME OF

SILVER LAKE IRRIGATION DISTRICT
SURVEYED JULY 24,25,28,29, 1975 by R.G.MUCKEN