


T6971

RECEIVED

MAY 03 1993

WATER RESOURCES DEPT.  
SALEM, OREGON

T. 12S., R. 4W., W.M.

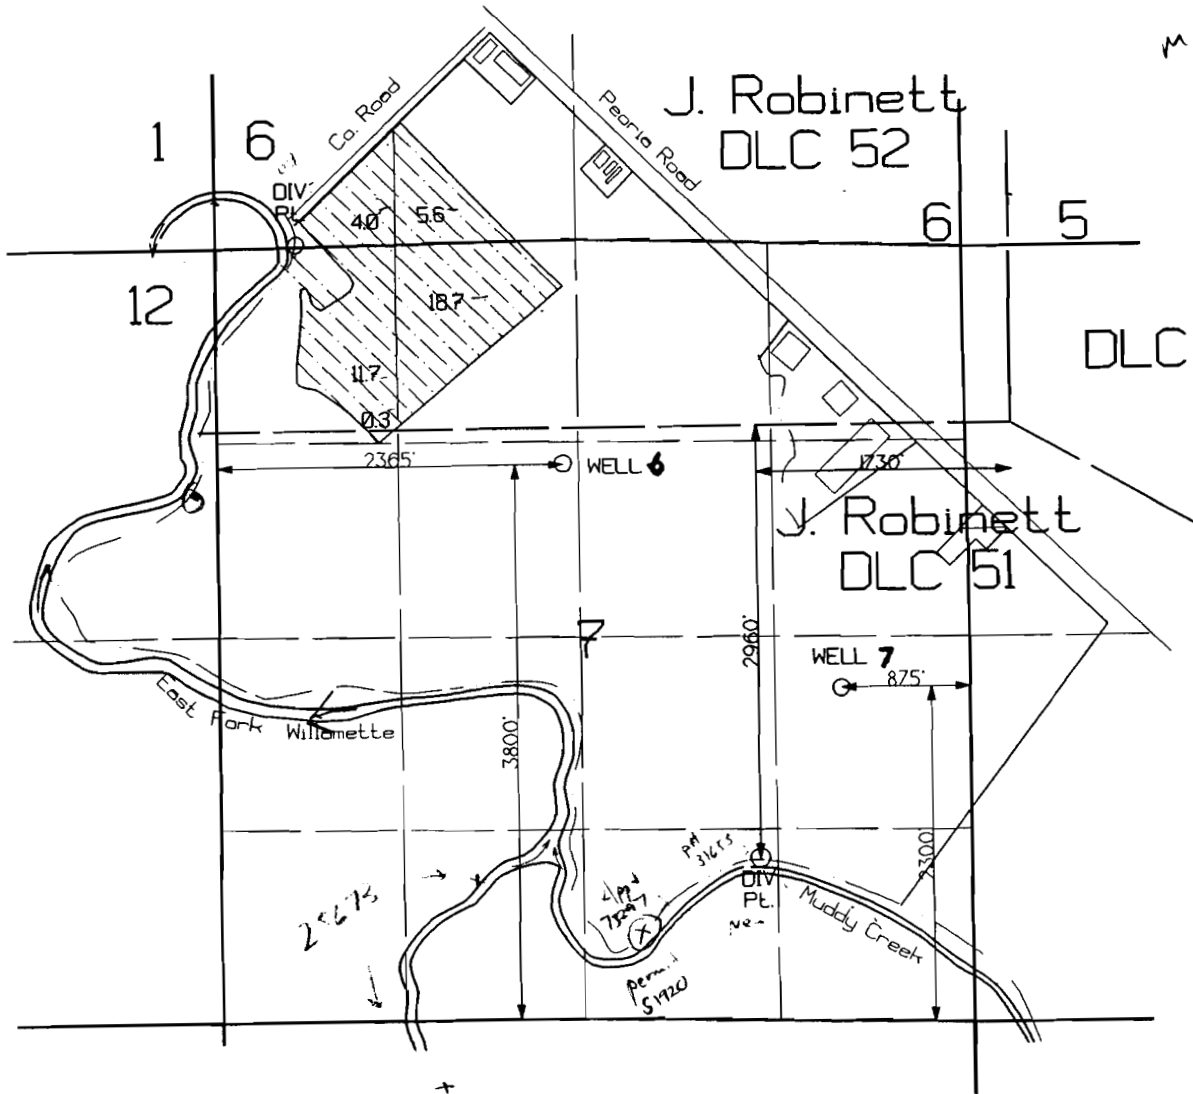

may be regulated to satisfy  
 If insufficient in Muddy cr. to meet existing portion of Transfer may be regulated to satisfy existing

N ↑

Water Right Application Map  
for: Roger Hamlin

1"=1320 Ft

