


T.14S.R.12E.W.M.

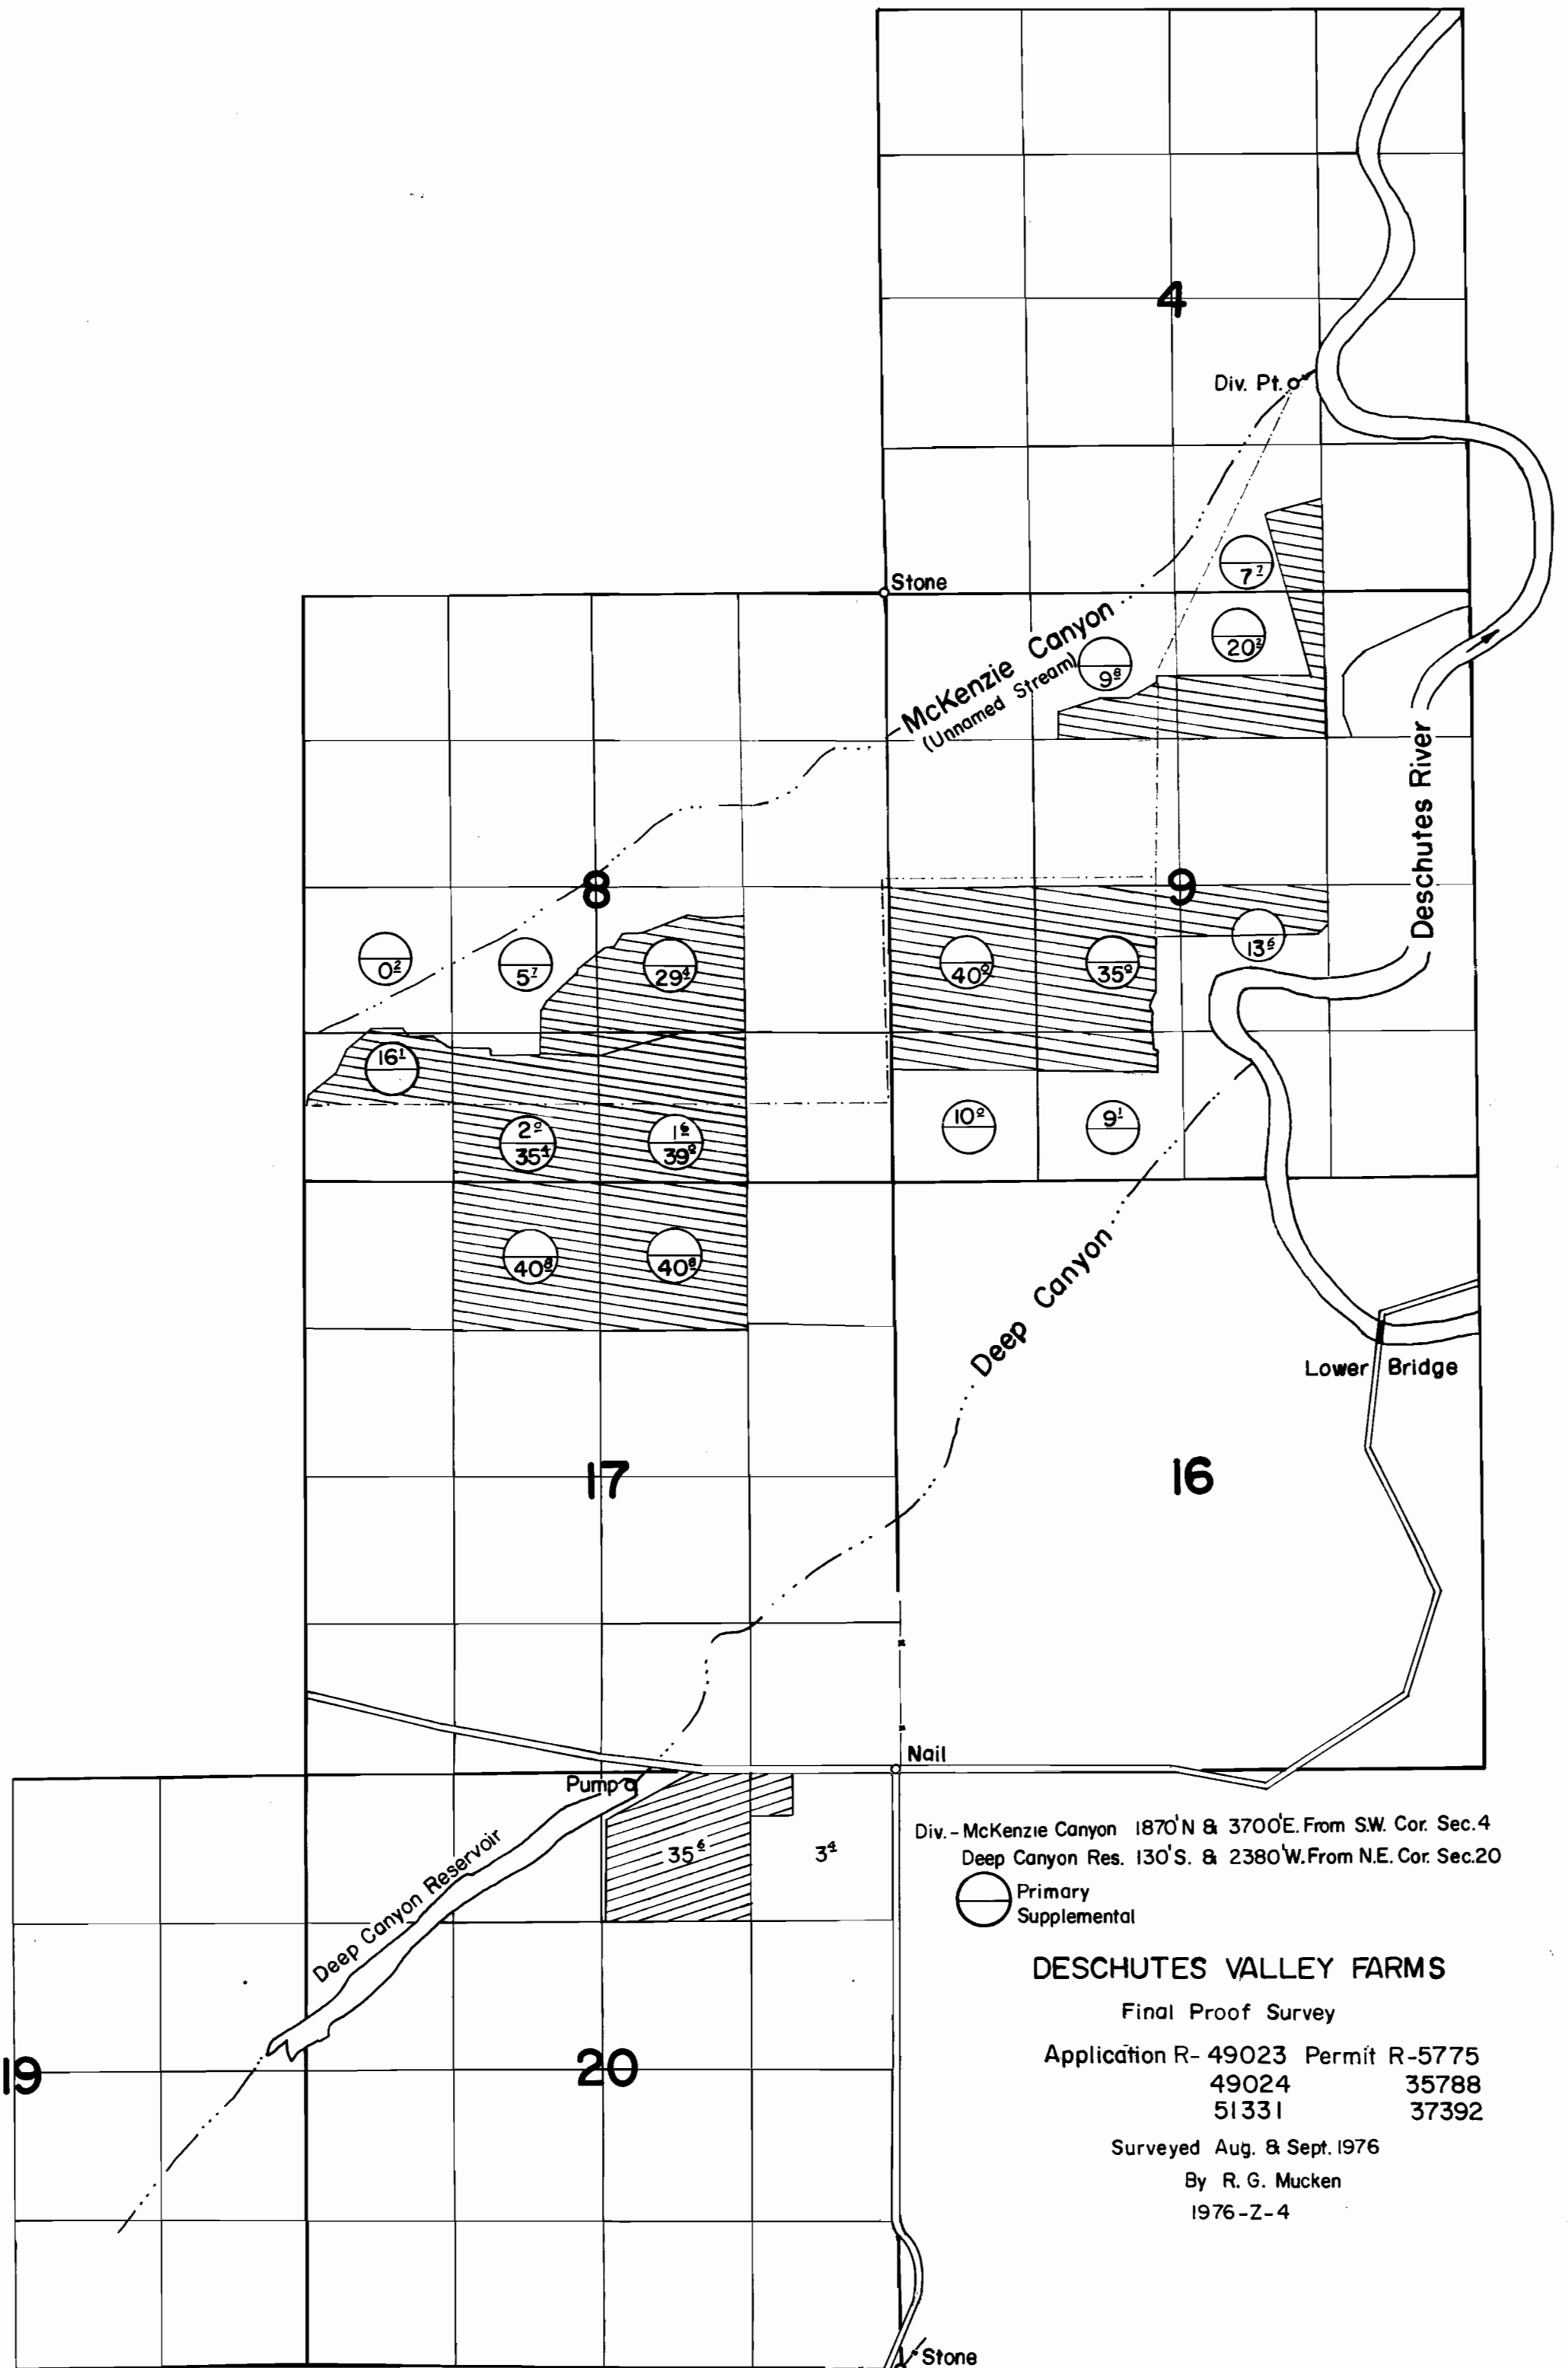

Div. - McKenzie Canyon 1870' N & 3700' E. From SW. Cor. Sec. 4
 Deep Canyon Res. 130' S. & 2380' W. From N.E. Cor. Sec. 20

○ Primary
 ○ Supplemental

DESCHUTES VALLEY FARMS

Final Proof Survey

Application R- 49023 Permit R-5775
 49024 35788
 51331 37392

Surveyed Aug. & Sept. 1976

By R. G. Mucken
 1976-Z-4