


T. 2N., R. 3W., W.M.

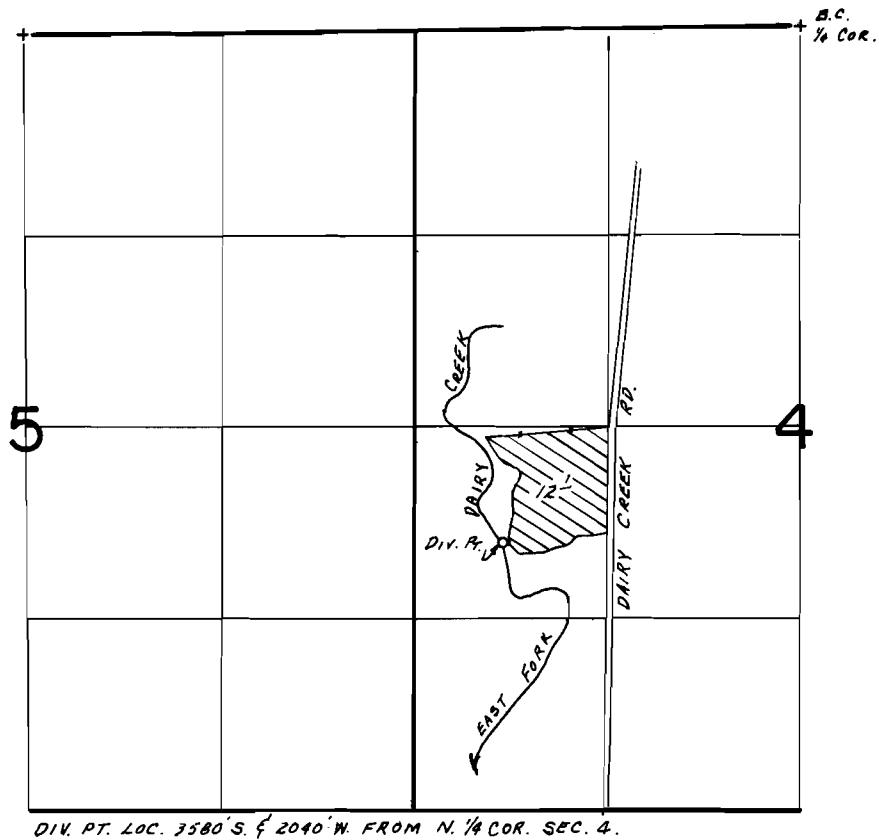

FINAL PROOF SURVEY
UNDER

Application No. 50038 Permit No. 36790
IN NAME OF

DUDLEY JONES

Surveyed MAY 30 19 80, by R.G. MUCKEN