


UNITED STATES
DEPARTMENT OF THE INTERIOR
BUREAU OF LAND MANAGEMENT

SECTION 27 **Oregon State Water Filings**

TOWNSHIP 19S, RANGE 39E, W. M.

Gregory Cr. Res. North

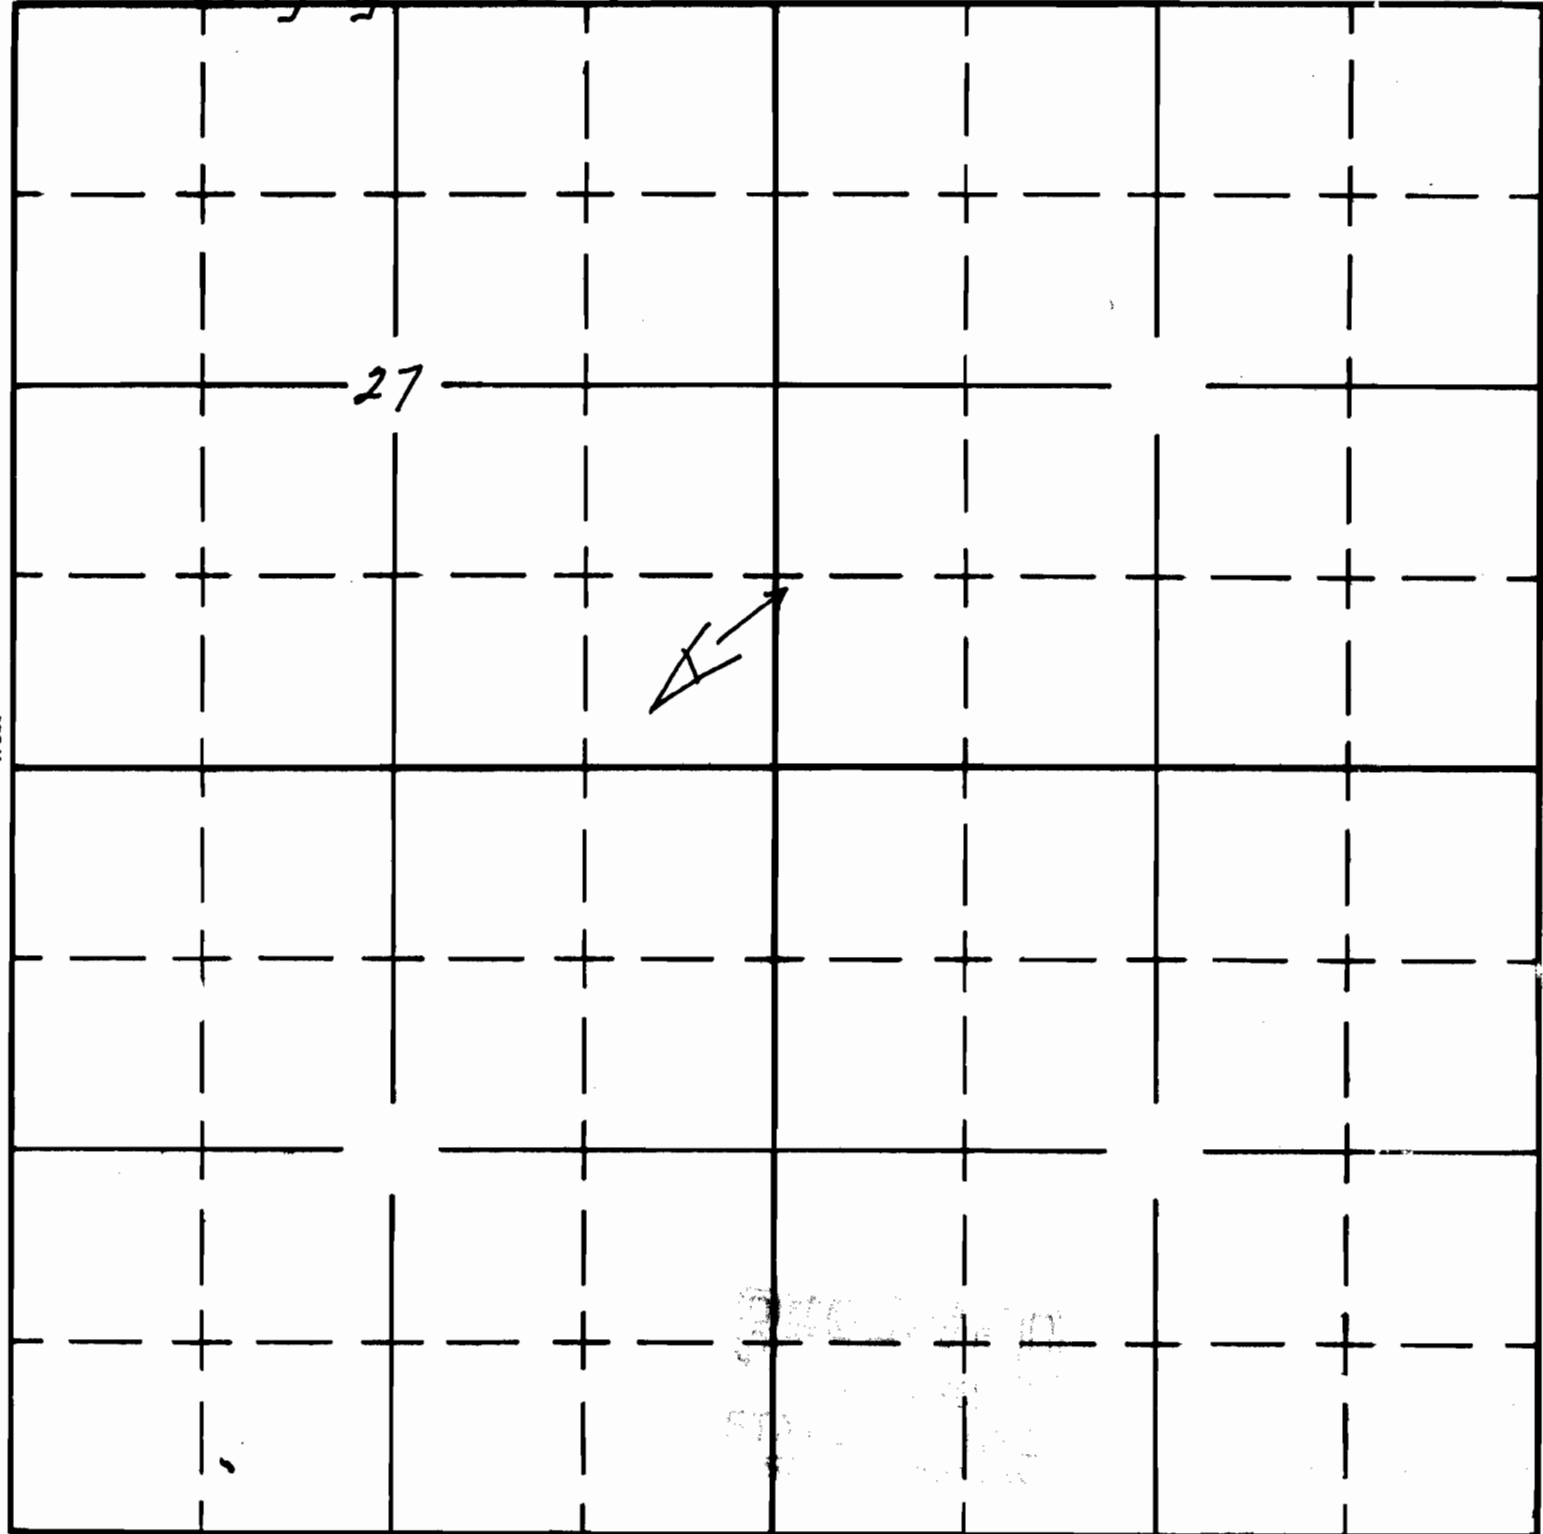

South