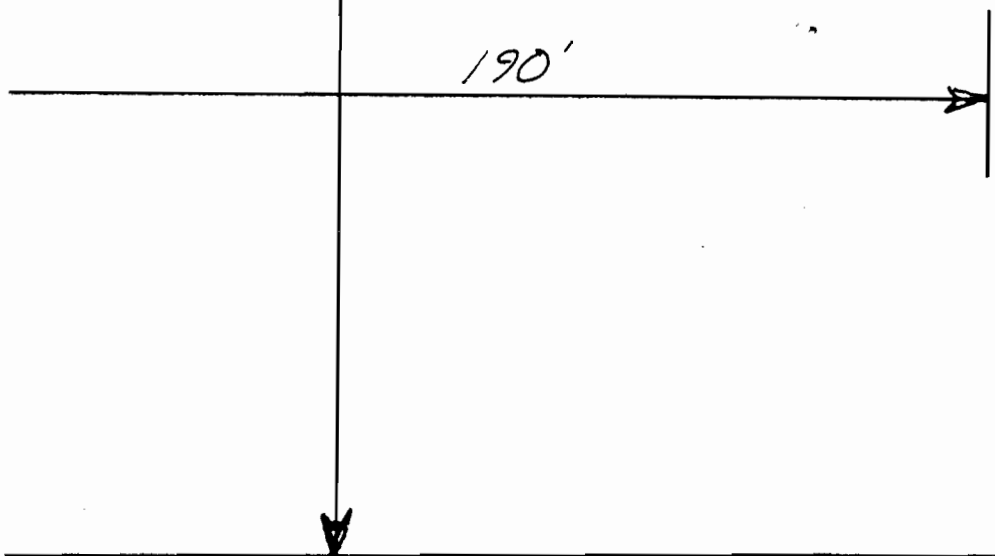
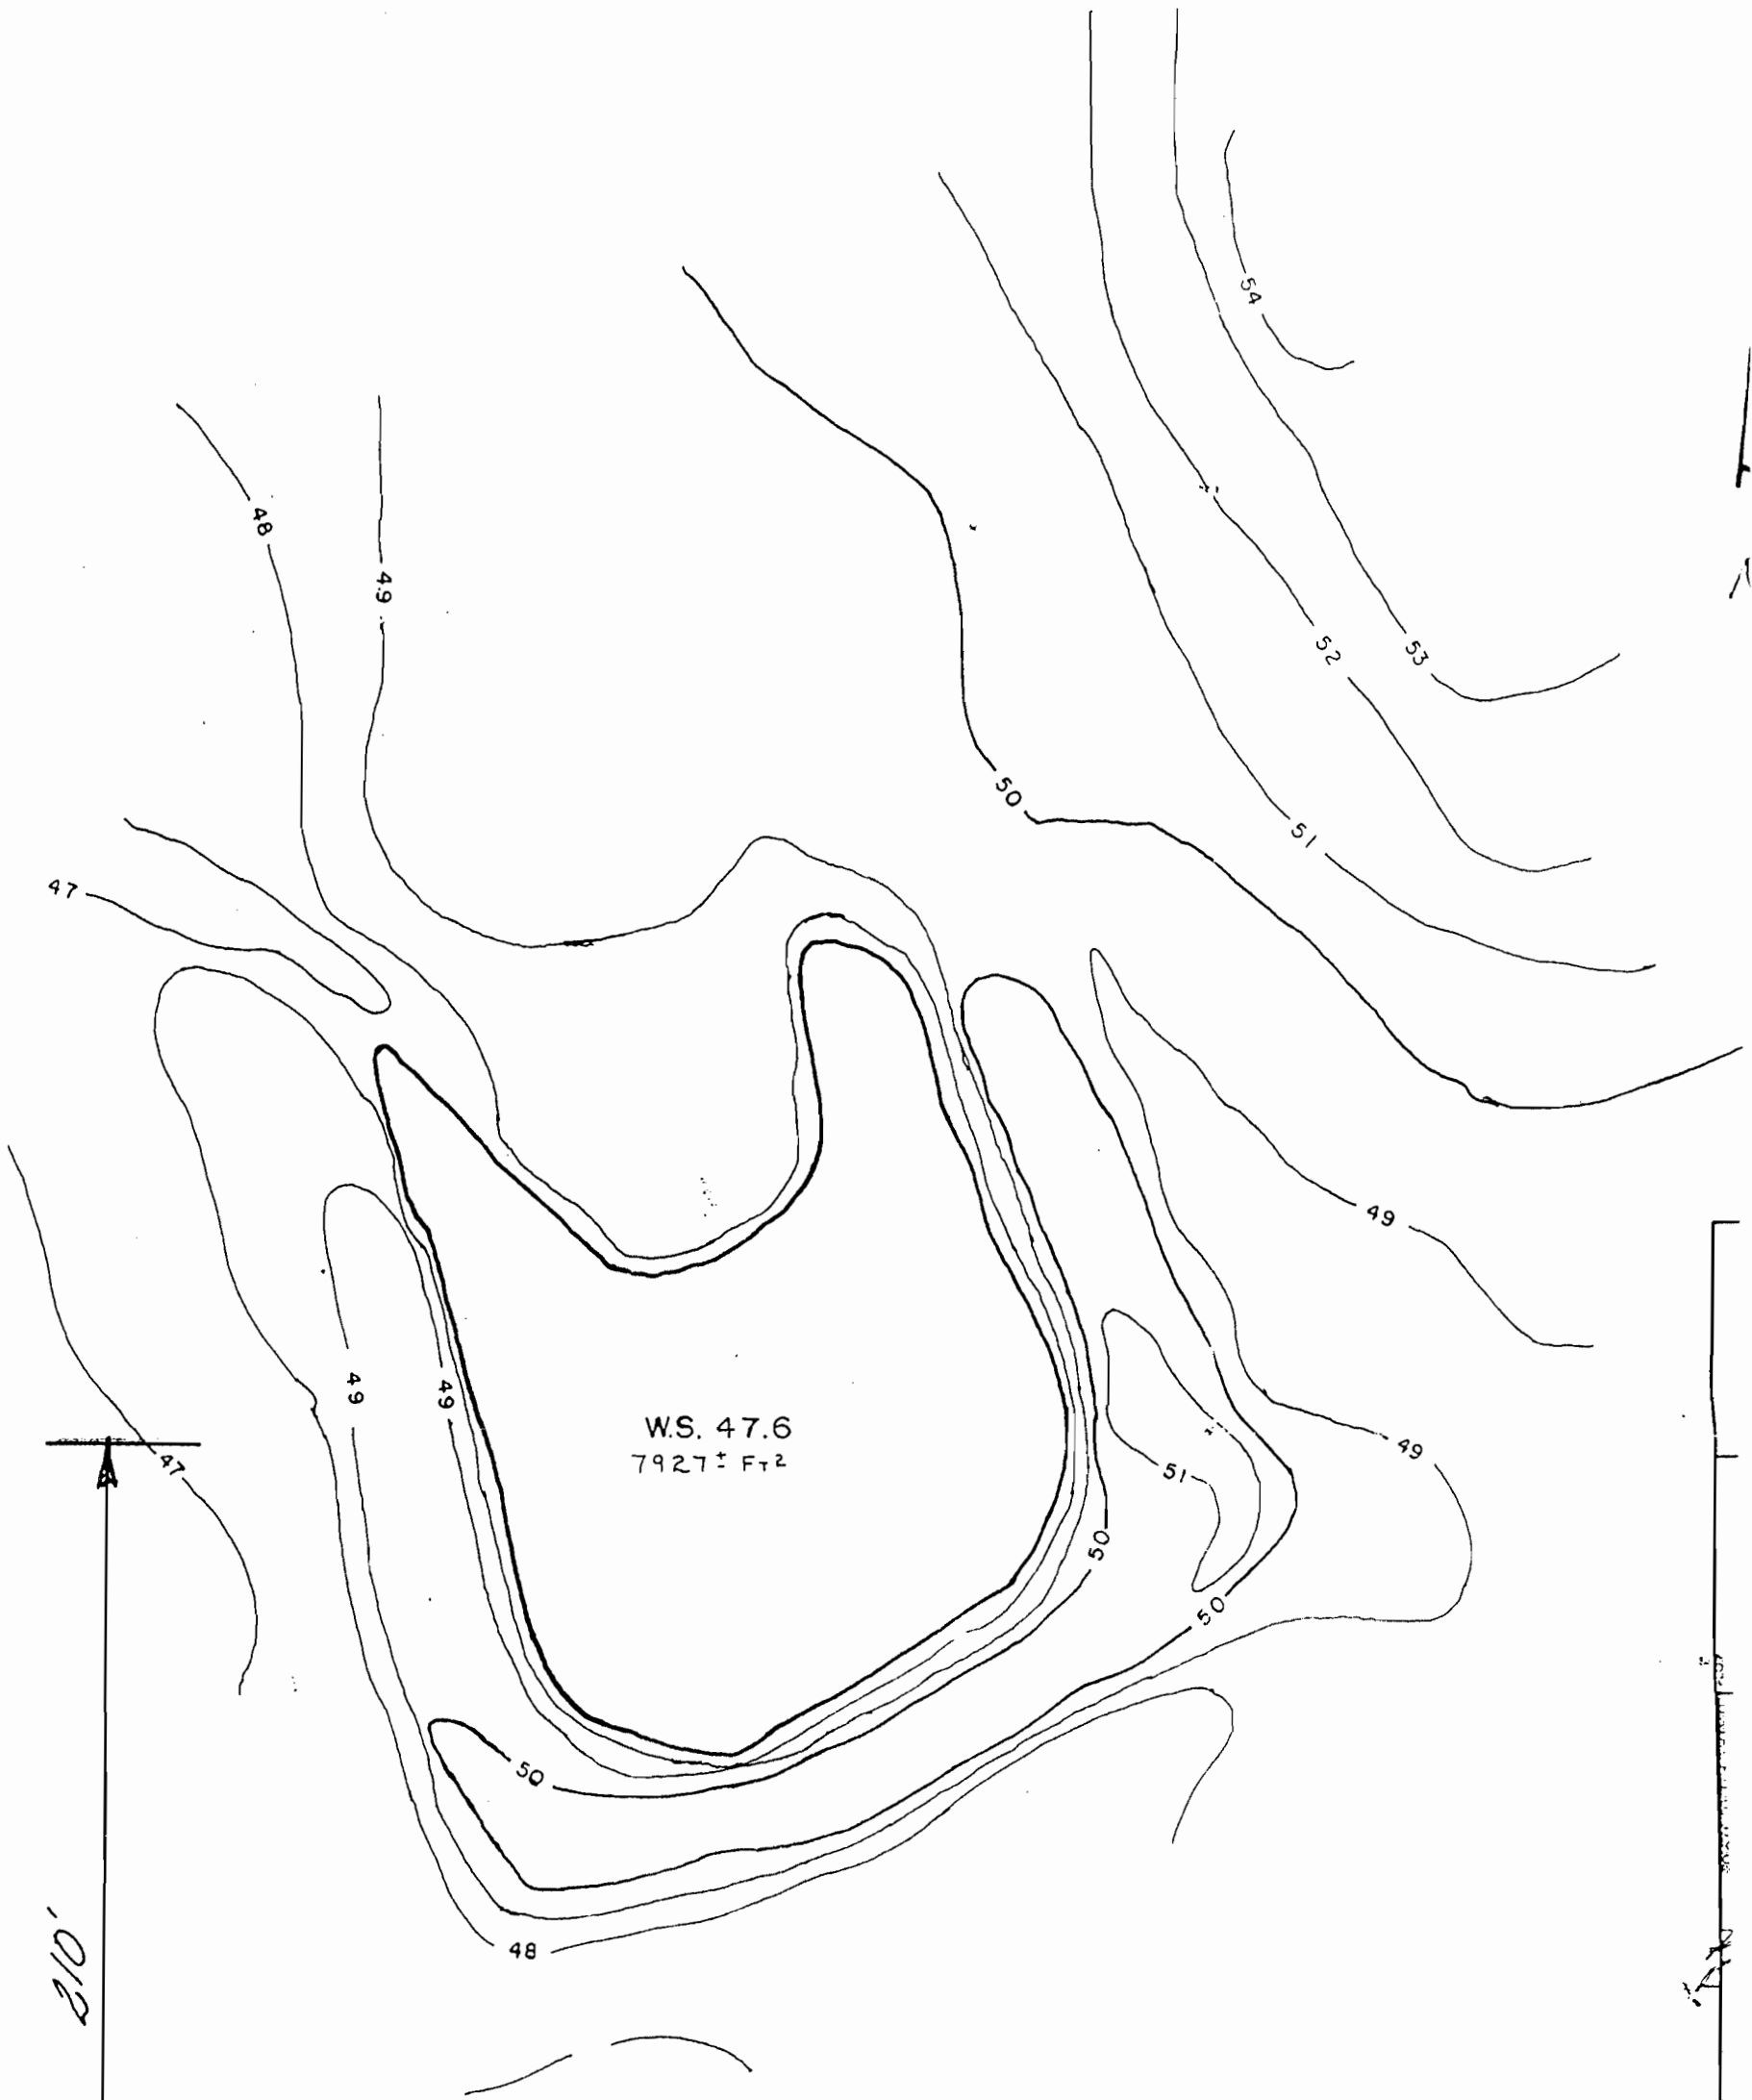


NE 1/4 SW 1/4 SEC 33

South line of NE 1/4 of SW 1/4 (Sec 33)
T16S, R1W, WM.

SITE

[Handwritten notes and signatures in a box]


RECEIVED

SEP - 3 1991

WATER RESOURCES DEPT
SALEM, OREGON

14

T.16S. R.1 W.W.M.
LANE COUNTY
1" = 4000'

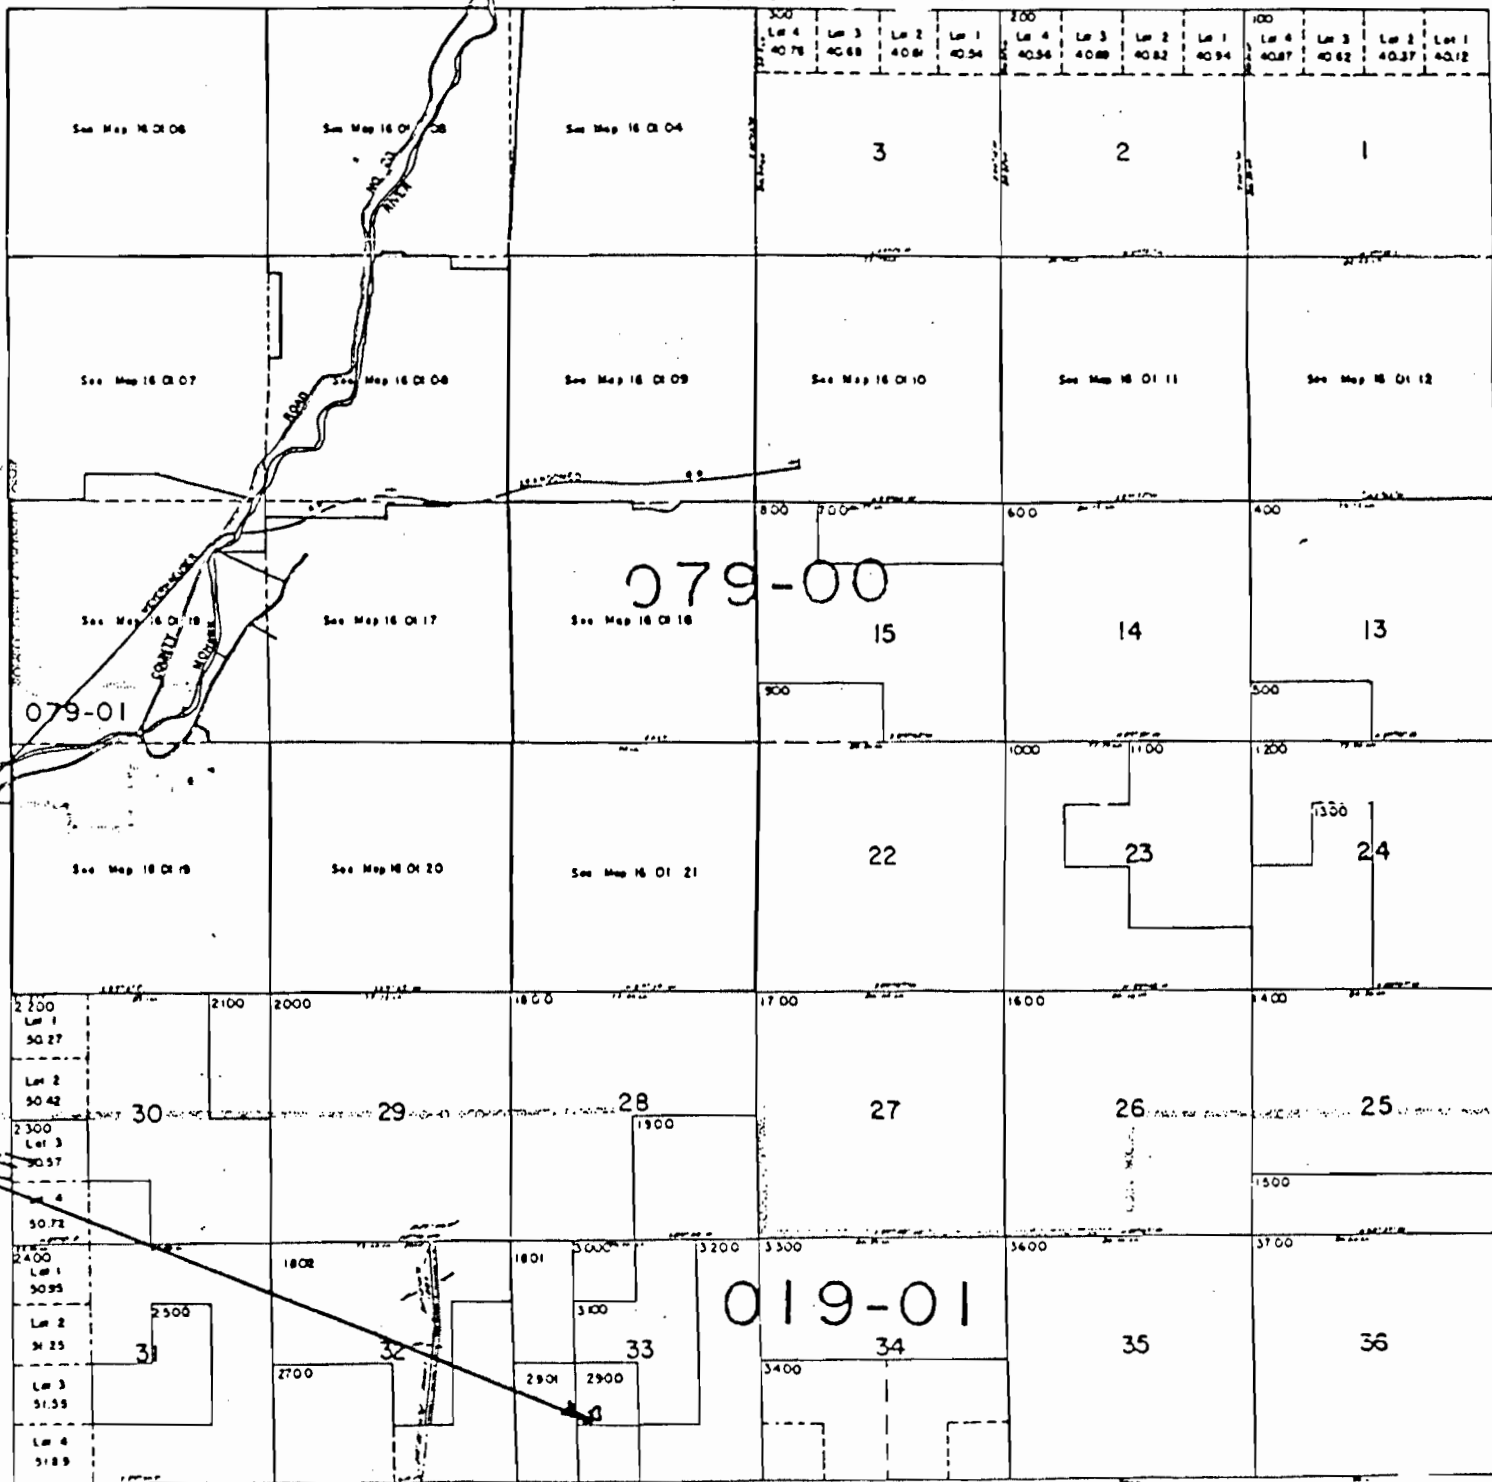

Designed:

Drawn: LLT

Revised:

TOM POAGE ENGINEERING & SURVEYING, INC.

P.O. BOX 2527

EUGENE, OR. 97402

485-4505

Project:

RESERVOIR FOR JIM COBB

Scale: 1" = 30'

Date: 7/25/91

Location:

SW 1/4, SEC 33, T16S, R1W, W.M.
LANE COUNTY, OREGON

Job No.: 1648

Flat File No.:

Sheet

/

of

/