


T. 34S., R. 6W., W. M.

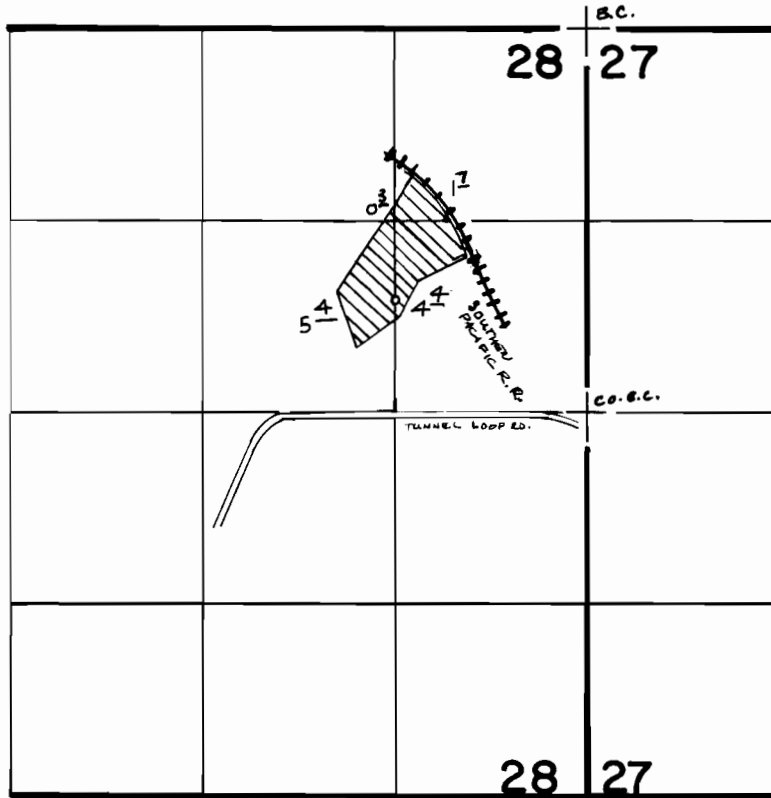

WELL: 1865' S. & 1320' W, FROM N.E. COR. SEC. 28

SCALE: 1" = 1320'

FINAL PROOF SURVEY
UNDER

Application No. ~~G-8233~~ Permit No. ~~G-10295~~...
IN NAME OF

DAVE P. UNRUH

.....
Surveyed .SEPT. 12. 1964., by J.R..WOODRUFF.