


T.5S.,R.1E.,W.M.

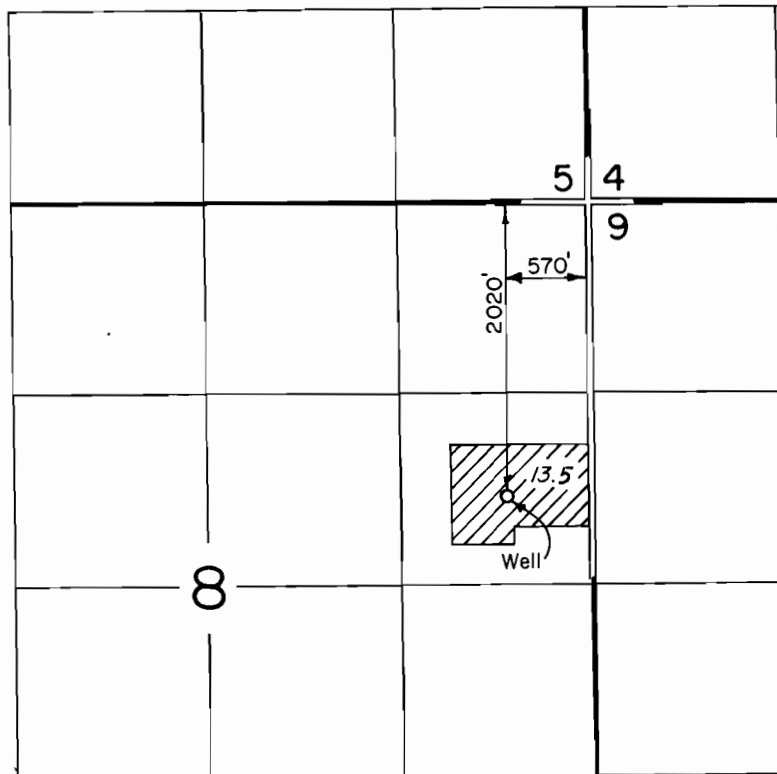

FINAL PROOF SURVEY
UNDER

Application No. G-9888 Permit No. G-8927
IN NAME OF

.....TIMOFIE AND AGRIPINA KYOKOV.....

Surveyed AUG. 10, 1981, by *[Signature]*