


T. 1 S., R. 8 W., W. M.

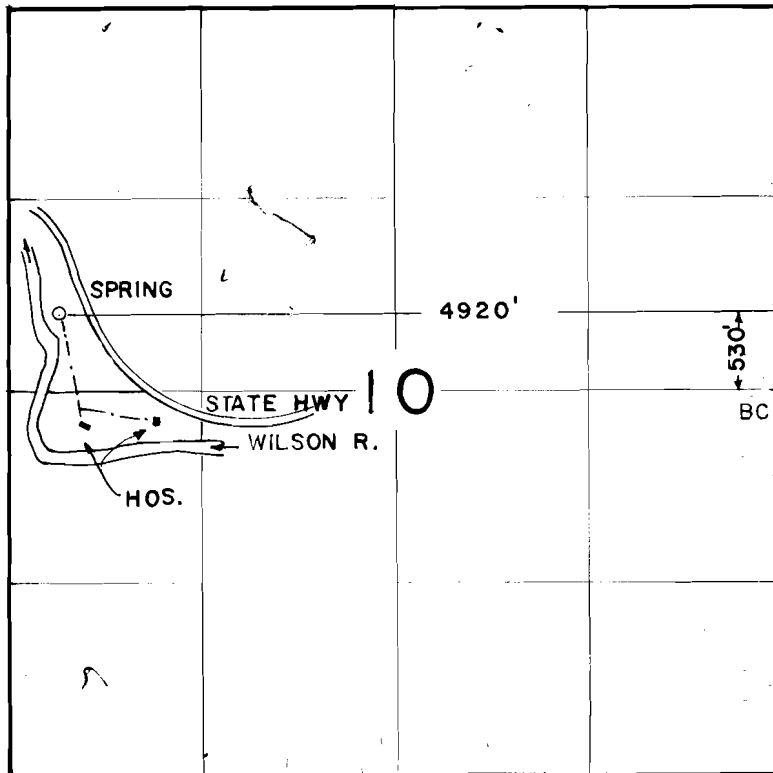

SCALE
1" = 1320'

FINAL PROOF SURVEY UNDER

Application No. 57473... Permit No. 43437...
IN NAME OF

ROBERT F. & ORETA K. YERGEN

Surveyed JUN...13... 1984, by P...PAGTER.....