


T. 32 S., R. 3 W., W.M.

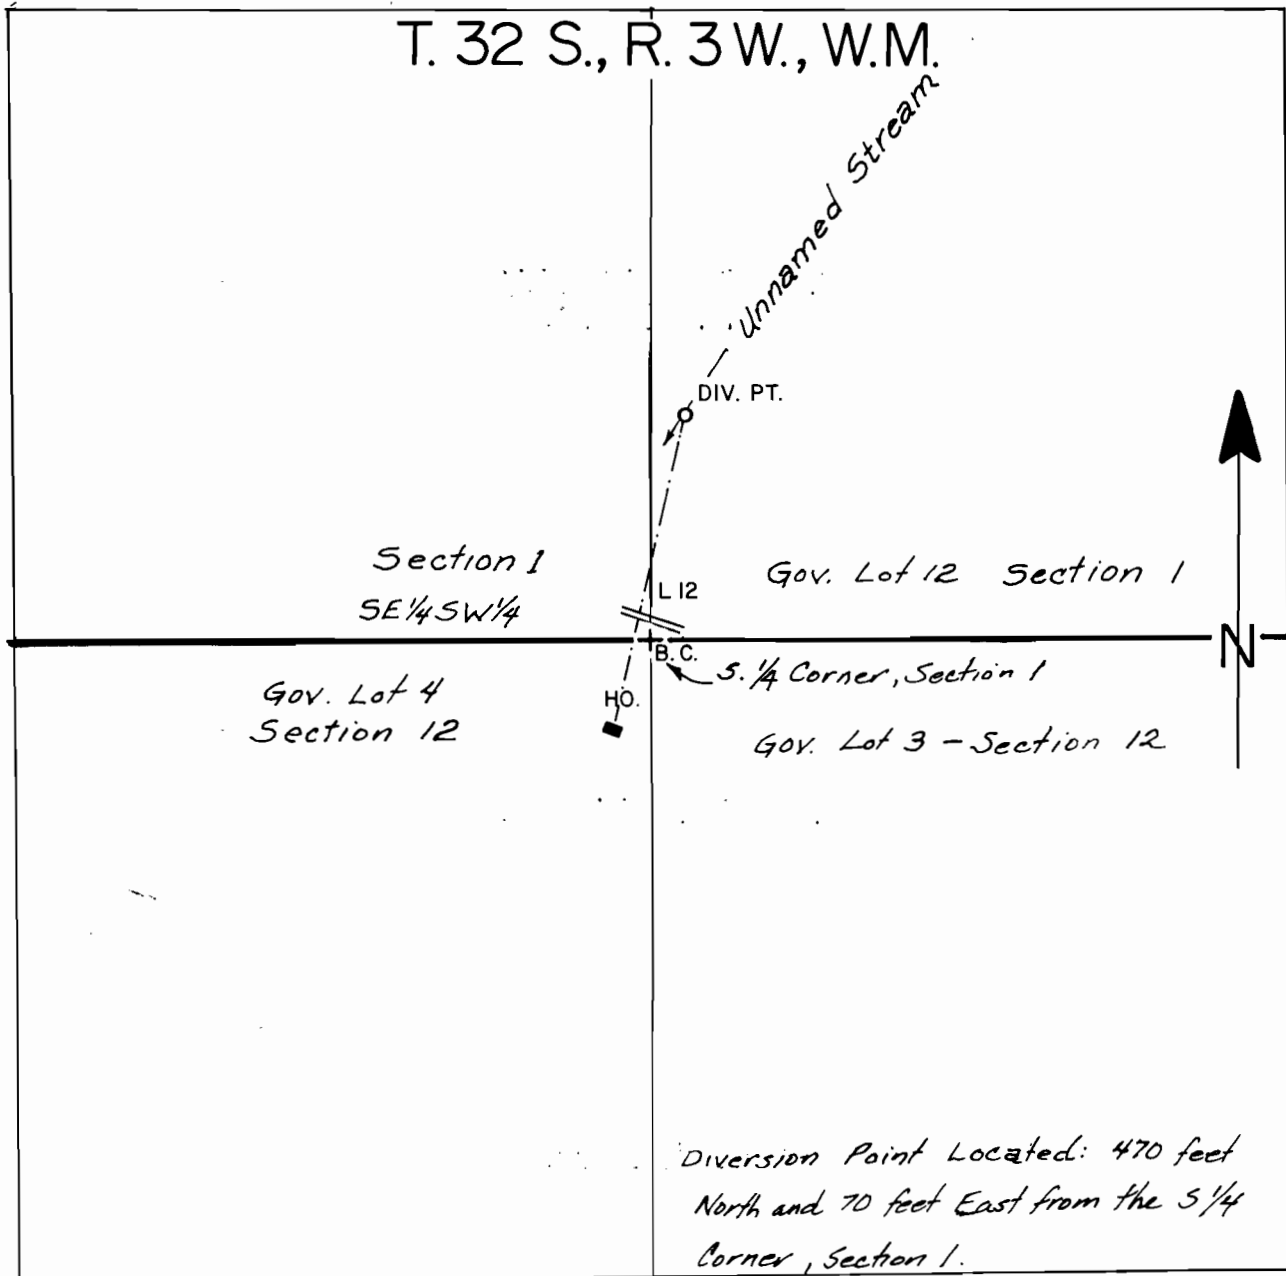

FINAL PROOF SURVEY
UNDER

SCALE 1" = 400'

Application No. 58640 Permit No. 44762.....

IN NAME OF

Guy D., Rose A. & Roger L. Hardage

Surveyed NOV. 16, 1984, by L. E. CASHION

Revised 6/15/98 *LLB*
PTS 1984 3/18/84 *LLB*