


T. 4 N., R. 7 W., W.M.

SECTION 4

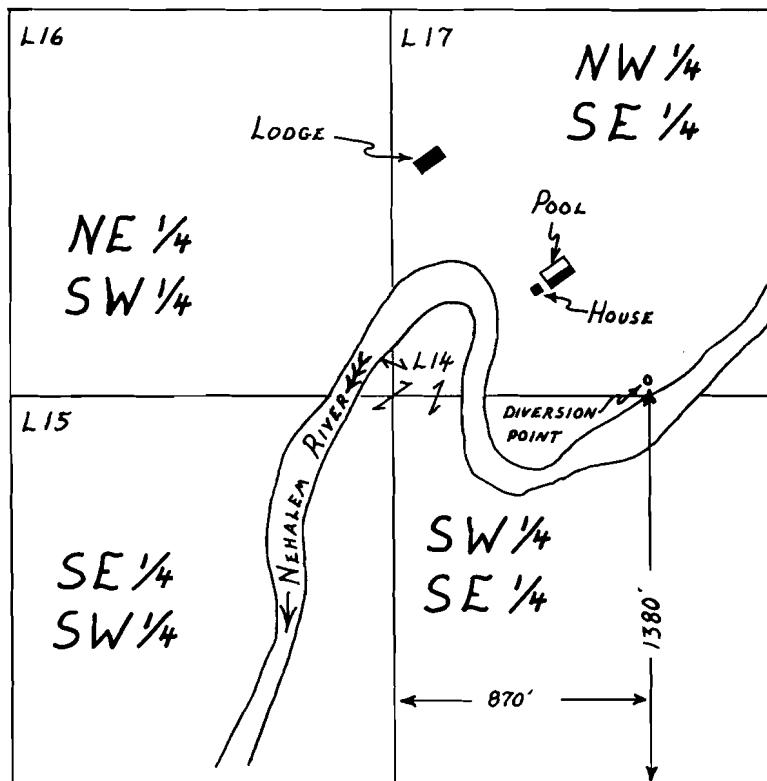

FINAL PROOF SURVEY

UNDER

Application No. 61763 Permit No. 46401
IN NAME OF

Milton O. Brown and Raymond J. Kittleson

Surveyed August 31, 1994, by R.W. Klassen