


RECEIVED

OCT 11 1993

WATER RESOURCES DEPT
SALEM OREGON

T.17S., R.1E., W.M.

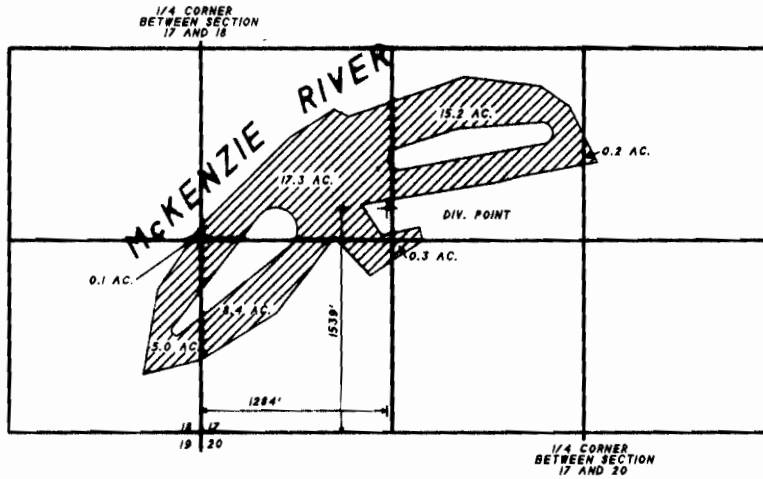

SCALE 1" = 1320'

FINAL PROOF SURVEY

APPLICATION NO. 70274 PERMIT NO. 51229

IN NAME OF

MCKENZIE RIVER GOLF COURSE INC.

SURVEYED SEPT. 28, 1993 BY TFP

