

CREEK


RECEIVED

JUL 19 1999

WATER RESOURCES DEPT.
SALEM, OREGON

TOWNSHIP 7 SOUTH
RANGE 1 EAST, WM
PORTION OF THE
NW 1/4 NE 1/4, SECTION 11
APPLICATION 74977
PERMIT R-11687

NO LIABILITY IS ASSUMED BY KEY FOR DISCREPANCIES IN THIS MAP AS OUTLINED AND THE ACCOMPANYING LEGAL DESCRIPTION.

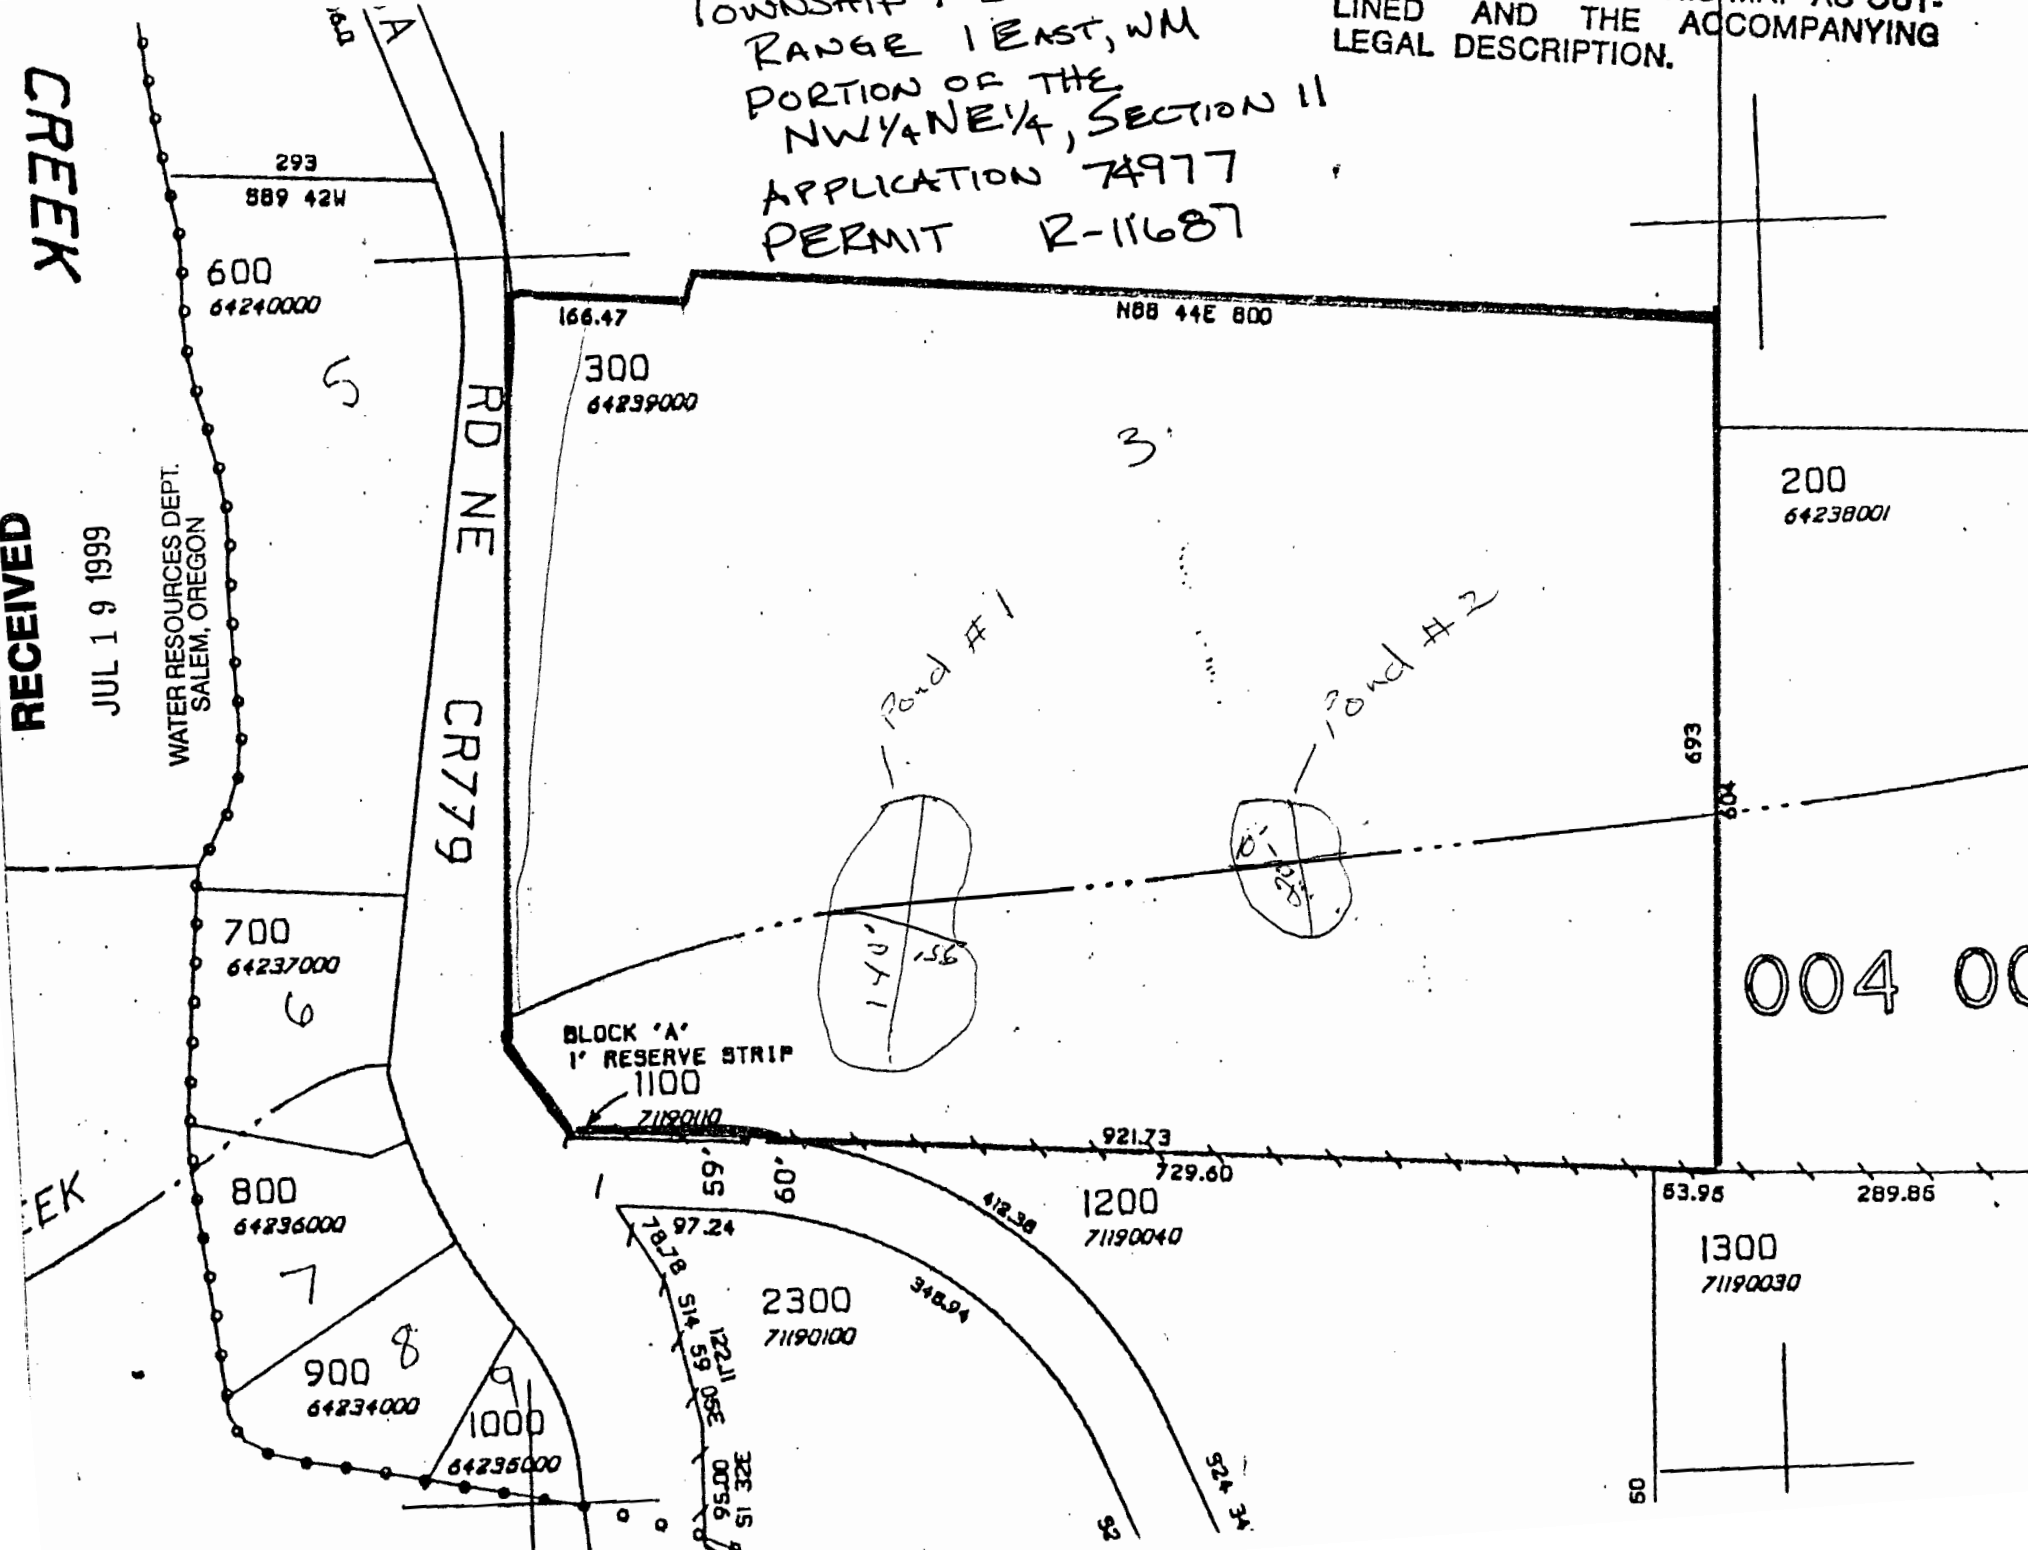

004 00

