


8458  
9711  
7461

Sec. 18 T. 38 S. R. 15 E. W. M. <sup>creek</sup>  
Sec. Cor.  $\frac{1}{4}$  COTT

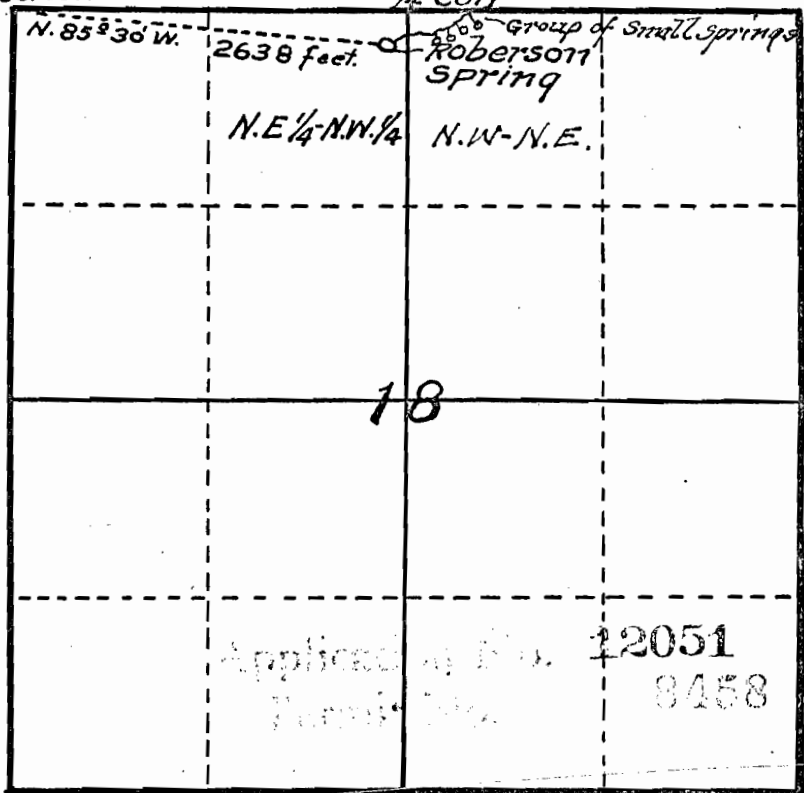

Registered Dec. 31 1919 No. 863 Charles A. Nuttler Civil Engr.

Fish Hole Cr.: Mac