


30270

4

T. 2 N. R. 12 E. W.M.

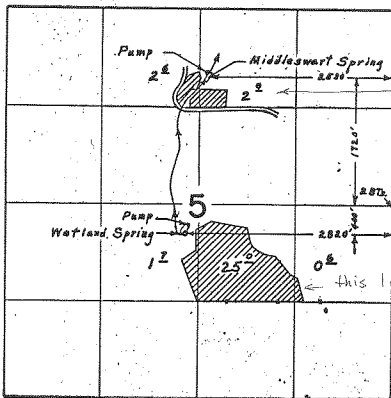

this land on this Certificate

this land had water right cancelled (V. 54, page 703)

FINAL PROOF SURVEY
UNDER

Application No. 40562. Permit No. 30270
IN NAME OF

U. C., BESSIE A., & WILLIAM F. MARSH

Surveyed Oct. 28, 1970, by L. E. Gould