

T10S, R9W, W.M.

SECTION 31

LINCOLN COUNTY, OREGON

RECEIVED


OCT 23 1997

OCT 23 1997

WATER RESOURCES DEPT
SALEM, OREGON

SCALE 1 inch = 400 feet

WATER RESOURCES DEPT
SALEM, OREGON

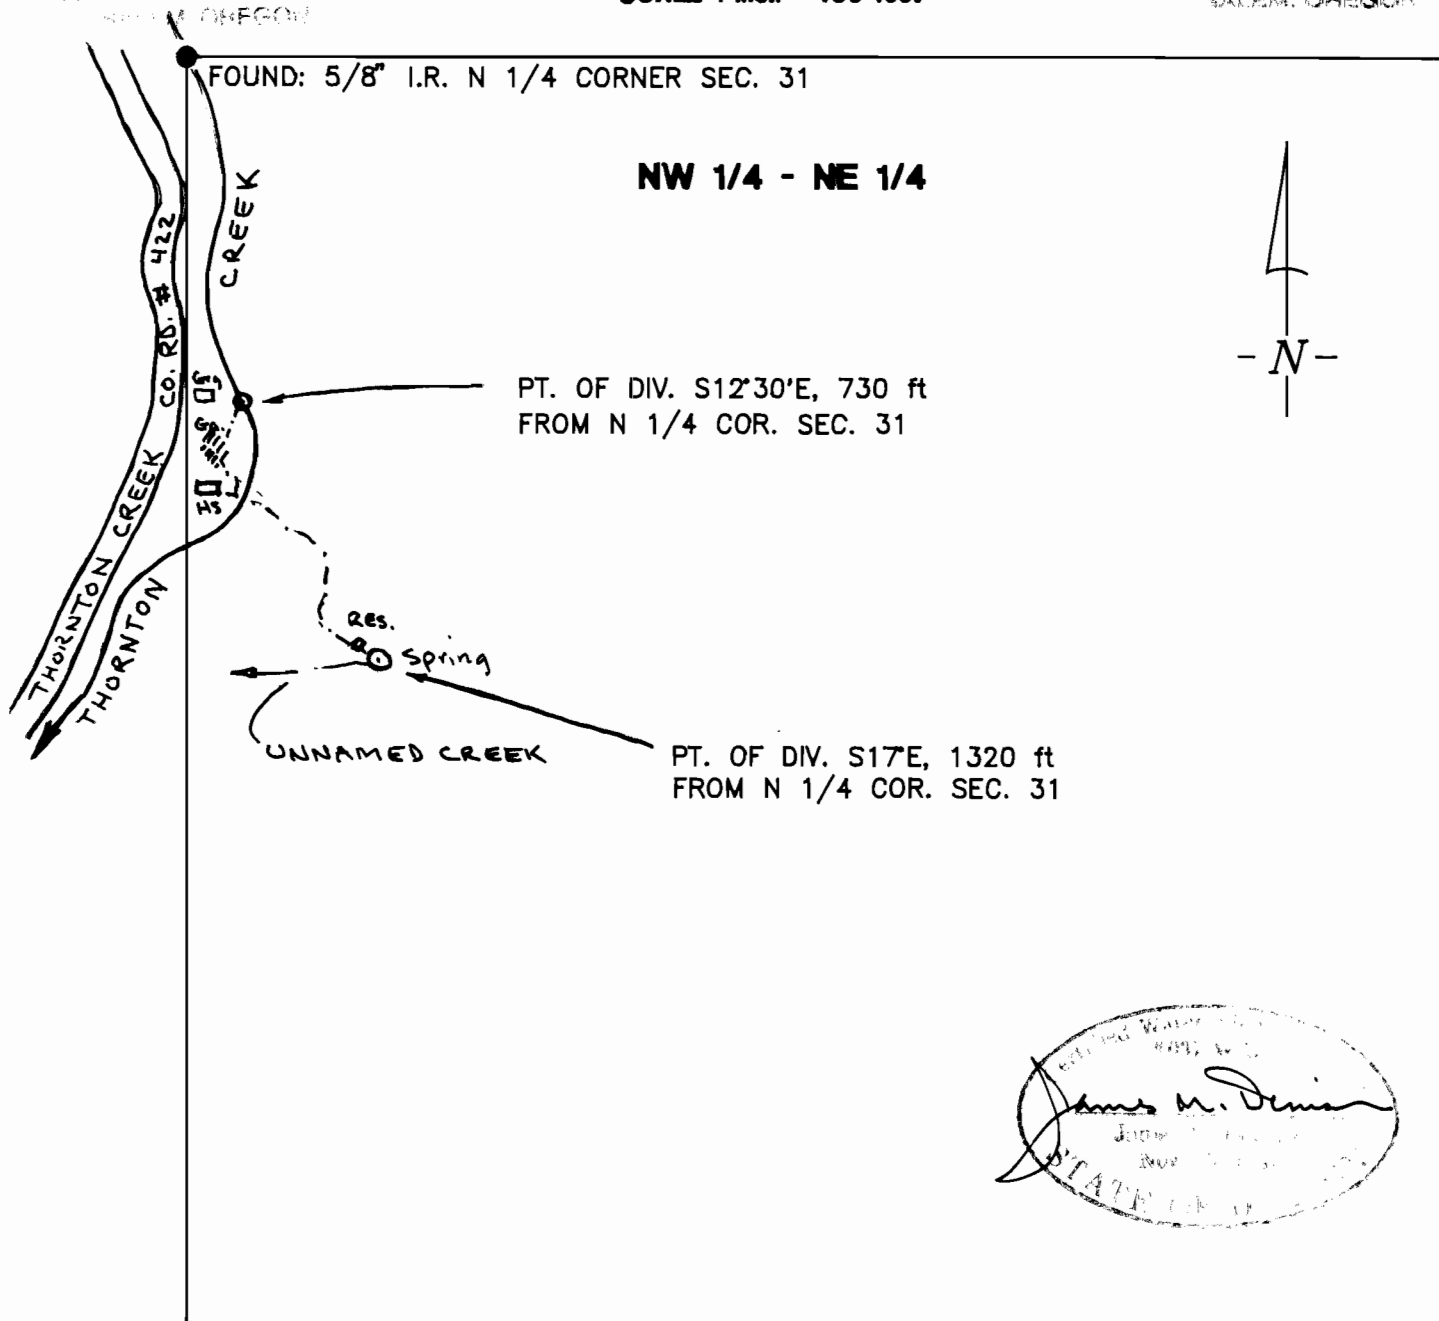

FINAL PROOF SURVEY UNDER

APPLICATION # 8-72992/ab

PERMIT # 52174

IN THE NAME OF

PAUL B. AND LETHA E. WEAVER

SURVEYED: APRIL 17, 1997

BY: J. M. DENISON

THIS MAP PREPARED SOLEY FOR THE PURPOSE OF SHOWING LOCATION OF A WATER RIGHT, AND
IS NOT INTENDED FOR USE TO PROVIDE DIMENSIONS OR LOCATION OF PROPERTY OWNERSHIP LINES