

Tax Lot No. TL200 23 12 5AA
Section 5 Township 23S Range 12W W.M.
Coos County


RECEIVED

OCT 21 1998

WATER RESOURCES DEPT.
SALEM, OREGON

E1/16

NE CORNER SECTION 5

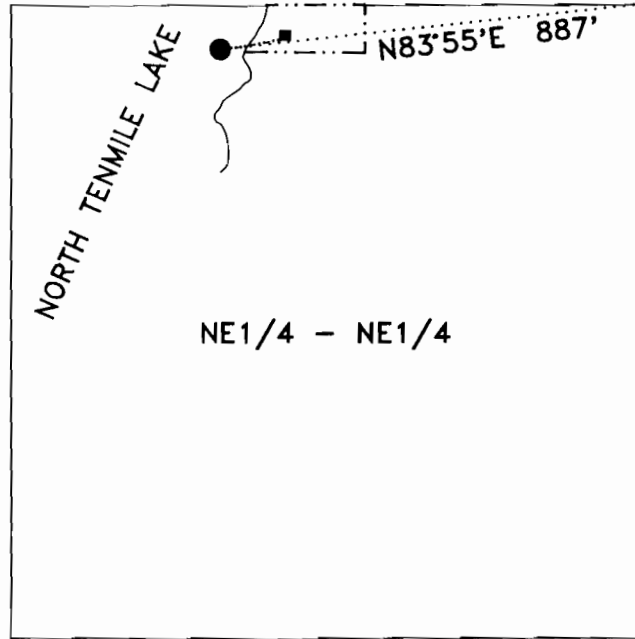

Scale 1" = 400'

LEGEND


- HOME
- POINT OF DIVERSION
- WATERLINE
- PROPERTY LINE

EXAMINERS DISCLAIMER STATEMENT

The preparation of this map was for the purpose of identifying the location of the Water Right only and has no intent to provide dimensions or location of property ownership lines.

FINAL PROOF SURVEY

IN THE NAME OF
Patricia O'Neil

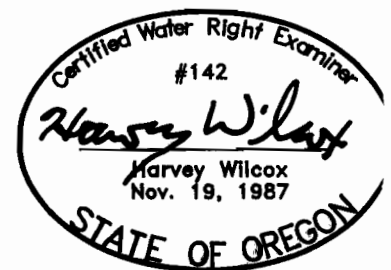

RENEWAL 6/30/00

Application No. S-80923

Permit No. 52918